

**SURVEY &  
REMONUMENTATION**

OCT 29 1996

COMMISSION


**LAND CORNER RECORDATION CERTIFICATE**

Filing Requirement of Act 74, Mich. P.A. 1970

For corners in  
MASON COUNTY  
(County)

Located In:

Corner Code #

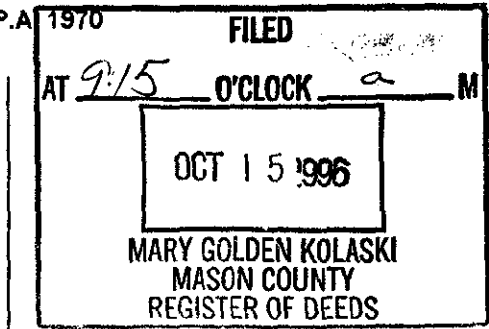

- 1. Public Land Survey      T 19N R 16W      B-9
- T            R
- T            R
- T            R
- 2. Property Controlling    S            T            R
- in Section                    S            T            R
- 3. Miscellaneous            S            T            R
- Property in Sec.            S            T            R
- 4. Lot No. \_\_\_\_\_, Recorded Plat \_\_\_\_\_
- 5. Private Claims \_\_\_\_\_

Register of Deeds Stamp & File Number

I, THEODORE H. WEINERT, in a field survey on SEPTEMBER 18, 1996, do hereby certify that under requirements of P.A. 74, Michigan P.A. of 1970, the corner points mentioned in lines 1 and 2 above were in conformance with regulations and rules therefore as required in the current manual of survey instructions of the United States Department of the Interior, Bureau of Land Management or by a decree of a Court of Law and/or that the corner points mentioned in lines 3, 4 and 5 above were in conformance with the rules of the Michigan Board of Land Surveyors or by a Decree of a Court of Law; established, re-established, monumented, re-monumented, recovered, found as expressed below:

**NOTE: Not more than 4 corners, all in the same town and range, may be recorded on this certificate.**

	A	B	C	D	E	F	G	H	I	J	K	L	M
1													
2	6	5	4	3	2	1							
3													
4	7	8	9	10	11	12							
5													
6	18	17	16	15	14	13							
7													
8	19	20	21	22	23	24							
9													
10	30	29	28	27	26	25							
11													
12	31	32	33	34	35	36							
13													

A. Description of original monument and accessories and/or subsequent restoration:  
 Sylvester Sibley subdivided the Township in 1838 and 1839. First Running West from the NE Corner to measure the closing mile, then, East Setting the Corner at 38.38 chains. Witnesses Taken: (1) Beech, 10", N 14° W, 10 links (2) do, 6", S 32° E, 17 links  
 In November 1904, R.O. Towns Completed a Survey in Section 30, and Set this Corner by measurement half way and on line. He did not use a proportionate measurement based on G.L.O., No Witnesses Taken.  
 In April, 1976 Kenneth L. Ross, RLS, Set a Concrete Monument at this location by proportionate measurement based on G.L.O. Witnesses Taken: (3) 10" Red Pine N 65° E, 31.19' (4) 8", Tw. Maple S60°E, 67.89' (5) 18" Locust Due West, 120.54'

No other data found in researching this corner.  
 B. Description of corner evidence found and/or method applied in restoring or reestablishing corner:  
 On September 18, 1996, I found the Concrete Monument as described by Kenneth L. Ross, RLS. Witnesses (1), (2), (4) and (5) have been destroyed. Witness (3) was standing and in good condition with the witness spike grown into the pine. I found no other evidence to dispute the location of this corner.

C. Description of monument for corner and accessories established to perpetuate locating the position of the corner:  
 I left the concrete Monument in place and did not set the standard Mason County Monument Cap on it and is accepted as a careful and faithful reestablishment of the position of the original corner. Witnesses Taken:  
 (3) New Spike next to old spike in 15" Maple, N65°E, 31.20'  
 Spike in Treated 6"X8" gate post, N87°E, 25.60'  
 Spike in Treated 6"X8" gate post, S56°E, 25.43'  
 Spike in 10" Jack Pine, N17°W, 28.74'  
 Spike in 12" Jack Pine, N 55°W, 46.90'  
 In Center of East West Two Track and old two track North.

Signed by *Therese Weinert*  
 Surveyor's Michigan License No. 19846

Date 9/30/96

FORM APPROVED BY MICHIGAN STATE BOARD OF LAND SURVEYORS, JAN. 28, 1971  
 REVISED MAY 14, 1975  
 REVISED JAN. 1983  
 ADAPTED FOR WORD PROCESSING MARCH, 1993

Peer Group Reviewed  
 and Approved  
 Date: 9-30-96  
*Kenneth L. Ross*  
 Mason County Surveyor