

SURVEY & REMONUMENTATION


OCT 29 1996

COMMISSION

For corners in

LAND CORNER RECORDATION CERTIFICATE
Filing Requirement of Act 74, Mich. P.A. 1970

MASON (County)	Located in:	Corner Code #
1. Public Land Survey	T ^{16W} _{19N} R ^{16W} _{13E}	R-13
	T ___ R ___	___
	T ___ R ___	___
	T ___ R ___	___
2. Property Controlling In Section	S ___ T ___ R ___	___
	S ___ T ___ R ___	___
3. Miscellaneous Property in Sec.	S ___ T ___ R ___	___
	S ___ T ___ R ___	___

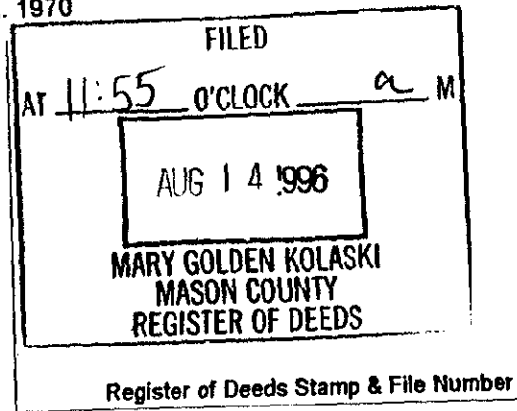

4. Lot No. _____, Recorded Plat _____
5. Private Claims _____

I, Sammy S. Barnett, in a field survey on July 25, 1996, do hereby state that under requirements of P.A. 74, Michigan P.A. of 1970, the corner points mentioned in lines 1 and 2 above were in conformance with regulations and rules therefore as required in the current manual of survey instructions of the United States Department of the Interior, Bureau of Land Management or by a decree of a Court of Law and/or that the corner points mentioned in lines 3, 4 and 5 above were in conformance with the rules of the Michigan Board of Land Surveyors or by a Decree of a Court of Law; established, re-established, monumented, recovered, found as expressed below:

NOTE: Not more than 2 corners, all in the same town and range, may be recorded on this certificate.

A	B	C	D	E	F	G	H	I	J	K	L	M
1												
2	6		5		4		3		2		1	
3												
4	7		8		9		10		11		12	
5												
6	18		17		16		15		14		13	
7												
8	19		20		21		22		23		24	
9												
10	30		29		28		27		26		25	
11												
12	31		32		33		34		35		36	
13												

A. Description of original monument and accessories and/or subsequent restoration:

B-13 South 1/4 Corner for Section 31, T19N, R16W.

1937, Mullet & Brookfield, boundary survey

Set wood Post

#1 Beech 24" N29°E 341ks.(22.44')

#2 Beech 12" N66°W 401ks.(26.40')

1895, JW Griswold, Dep. Co. Sur.

Makes note; set by Eastman

monument not given

R.O. Towns, 1901, Dep. Co. surv.

Stone & Crockery

Distance East 2645.28'

Distance West 2537.70'

1976, K. Ross, #17634

Set 1/2" Rebar @ fence to the

North (cont.)

#3 Power Pole North 35.46'

#4 Power Pole S80°W 103.96'

#5 1/2" Re-Rod East 45.18'

B. Description of corner evidence found and/or method applied in restoring or reestablishing corner:

B-13 South 1/4 Corner for Section 31, T19N, R16W.

On July 25, I found a R.L.S. capped Re-rod(#17634, Ross) 4 foot South of the center-line of Decker Road, 0.5 foot below gravel road, also found an old fence line due North. I found no evidence to dispute this location for the corner.

Condition of recorded witnesses are;

#1 Gone

#2 Gone

#3 Found in good condition

#4 Found in good condition

#5 Found in good condition

C. Description of monument for corner and accessories established to perpetuate locating the position of the corner:

B-13 South 1/4 Corner for Section 31, T19N, R16W.

I replaced existing 1/2" re-rod, in the exact location with a Standard Mason County Monument, placed 1.0 foot below gravel road, and is accepted as a careful and faithful reestablishment of the position of the original corner.

(ext. BP #3) Power Pole N 05° W 35.48'(60d spike in West side of pole)

(ext. BP #4) Power Pole S 80° W 103.92'(16p w/ shiner in SE side of pole)

Spruce 8" N 15° W 39.83'(60d spike in NE side of tree)


Iron Pipe 1" North 32.98'

North 1/4 corner for Section 6, T18N, R16W, East 45.18'

Signed by Sammy S. Barnett

Surveyor's Michigan License No. 16923

Date 8-12-96

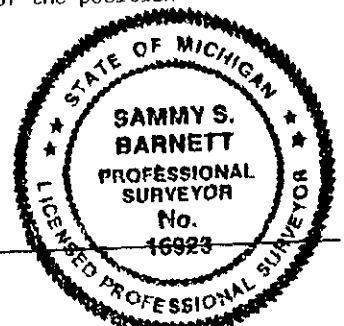

Peer Group Reviewed and Approved
Date: 8-13-96
Kenneth L. Ross
Mason County Surveyor