

SURVEY & REMONUMENTATION

MAR 16 1998

LAND CORNER RECORDATION CERTIFICATE

SECTION

Filing Requirement of Act 74, Mich. P.A. 1970

For corners in Mason Located In: _____ Corner Code # _____
 (County)


1. Public Land Survey T 19N R 16W _____ C-1 _____
 T _____ R _____
 T _____ R _____
 T _____ R _____

2. Property Controlling S _____ T _____ R _____
 in Section S _____ T _____ R _____

3. Miscellaneous S _____ T _____ R _____
 Property in Sec. S _____ T _____ R _____

4. Lot No. _____, Recorded Plat _____

5. Private Claims _____

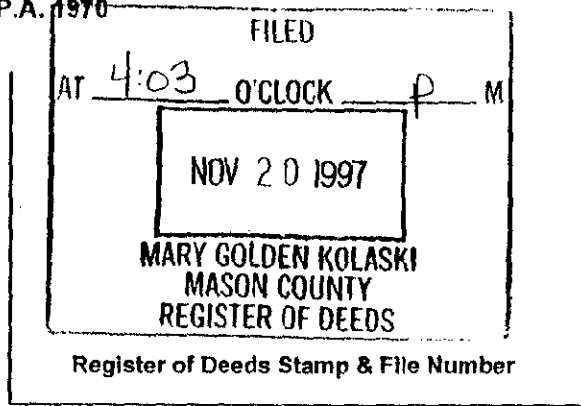

I, Richard L. Hays, in a field survey on August 1997, do hereby certify that under requirements of P.A. 74, Michigan P.A. of 1970, the corner points mentioned in lines 1 and 2 above were in conformance with regulations and rules therefore as required in the current manual of survey instructions of the United States Department of the Interior, Bureau of Land Management or by a decree of a Court of Law and/or that the corner points mentioned in lines 3, 4 and 5 above were in conformance with the rules of the Michigan Board of Land Surveyors or by a Decree of a Court of Law; established, re-established, monumented, re-monumented, recovered, found as expressed below:

NOTE: Not more than 4 corners, all in the same town and range, may be recorded on this certificate.

A. Description of original monument and accessories and/or subsequent restoration:
 C-1 NORTHEAST CORNER SECTION 6, T19N-R16W
 1839; G.L.O. Survey
 10" Hemlock S-50°-E 10 Lks (1)
 16" Beech S-78°-W 30 Lks (2)
 Standard Corner East 44 Lks (3)

B. Description of corner evidence found and/or method applied in restoring or reestablishing corner:
 C-1 NORTHEAST CORNER SECTION 6, T19N-R16W
 August 1997: Found no evidence of Corner. G.L.O. distance roughly fit the Centerline of Road going South.
 Set Corner on line between the controlling Standard Corners.
 Condition of the Witnesses are as follows:
 10" Hemlock S-50°-E 10 Lks (1) (GONE)
 16" Beech S-78°-W 30 Lks (2) (GONE)
 Standard Corner East 44 Lks (3) (FOUND)

C. Description of monument for corner and accessories established to perpetuate locating the position of the corner:
 C-1 NORTHEAST CORNER SECTION 6, T19N-R16W
 August 1997: Set a Standard Mason County Monument and is accepted as a careful and faithful re-establishment of the Position of the Original Corner with the following witnesses:
 1/2" Re-Rod S-68°-E 35.10'
 1/2" Re-Rod S-87°-W 84.98'
 1/2" Re-Rod N-25°-W 70.30'
 1/2" Re-Rod N-05°-W 63.13'
 Spike in NE side of Power Pole S-54°-W 41.22'
 5/8" Re-Rod West 29.04'

	A	B	C	D	E	F	G	H	I	J	K	L	M
1													
2	6	5	4	3	2	1							
3													
4	7	8	9	10	11	12							
5													
6	18	17	16	15	14	13							
7													
8	19	20	21	22	23	24							
9													
10	30	29	28	27	26	25							
11													
12	31	32	33	34	35	36							
13													

Signed by Richard Hays Date 11/6/97
 Surveyor's Michigan License No. 25847

