

FEB 08 2000


LAND CORNER RECORDATION CERTIFICATE

Filing Requirement of Act 74, Mich. P.A. 1970

SECTION

For corners In: Located In: Corner Code #
Mason County

- 1. Public Land Survey T 19N R 16W C-13
- 2. Property Controlling in Section S T R
- 3. Miscellaneous S T R
- Property in Sec. S T R

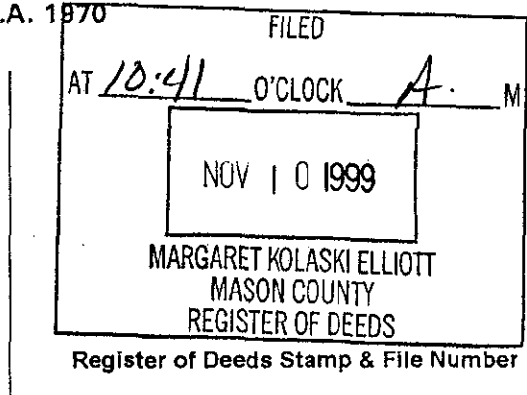

- 4. Lot No. _____, Recorded Plat _____
- 5. Private Claims _____

I, Kenneth L. Ross, in a field survey on September 11, 1999, Do hereby certify that under requirements of P.A. 74, Michigan P.A. of 1970, the corner points mentioned in lines 1 and 2 above were in conformance with regulations and rules therefore as required in the current manual of survey instructions of the United States Department of the Interior, Bureau of Land Management or by a decree of a Court of Law and/or that the corner points mentioned in lines 3, 4 and 5 above were in conformance with the rules of the Michigan Board of Land Surveyors or by a Decree of a Court of Law; established, re-established, monumented, re-monumented, recovered, found as expressed below:

	A	B	C	D	E	F	G	H	I	J	K	L	M
1													
2	6	5	4	3	2	1							
3													
4	7	8	9	10	11	12							
5													
6	18	17	16	15	14	13							
7													
8	19	20	21	22	23	24							
9													
10	30	29	28	27	26	25							
11													
12	31	32	33	34	35	36							
13													

NOTE: Not more than 4 corners, all in the same town and range, may be recorded on this certificate.

A. Description of original monument and accessories and/or subsequent restoration:

Corner Common to Sections 31 and 32, T.19N., R.16W.,

- Mullett and Brockfield, 1838 "Set Post Corner 31 & 32"
(1) Beech, 20", N36°E, 55 links (36.30')
(2) Beech, 10", N13°W, 28 links, (18.48')
- R.O. Towns, 1901, Book 4, page 52 "Stone for Corner" No Witnesses Given.
Distance West to B-13, 2645.28'
Distance North to C-12, 2708.64'
- K.L. Ross, 1977, Act 132, Liber 1, page 455. Does not state what he found. No Witnesses Given.
Distance West to B-13, 2650.10'
- J.W. Griswold, 1895, Book 1, page 286 "Set by Eastman, 58 links (38.28') East of post to 5 & 6, T.18N., R.16W. No new Witnesses Given.
Distance West to B-13, 2640.00'
Distance North to C-12, 2679.60'
- R.O. Towns, 1903, Book 2, page 184 "Stone for Corner" No Witnesses Given.
Distance East to D-13, 2630.76'
Distance North to C-12, 2709.76'
- K.L. Ross, Act 132, 1984, "Existing Iron" No Witnesses Given.
Distance East to E-13, 5259.10'
- K.L. Ross, Act 132, 1990, "1" pinched iron" No Witnesses Given.
Distance West to B-13, 2651.09'

B. Description of corner evidence found and/or method applied in restoring or reestablishing corner:

Corner Common to Sections 31 and 32, T.19N., R.16W.,

I found 2 pieces of 5/8" X 8" re-rod on the East side of a large stone (believed to be as described by R.O. Towns), 2' South of the center-line of Decker Road and on the center-line of Darr Road to the North. Witnesses (1) and (2) above have been destroyed. I found no other evidence to dispute the location of this corner.

C. Description of monument for corner and accessories established to perpetuate locating the position of the corner:

Corner Common to Sections 31 and 32, T.19N., R.16W.,

I replaced the center of the 2 pieces of 5/8" X 8" re-rod in the exact location with a 5/8" X 24" iron re-rod with a standard 3" aluminum cap stamped "Mason County Monument", on the East side of the large stone, 2' South of the center-line and 1 foot below the gravel surface of Decker Road, on the center-line of Darr Road to the North. and accepted this corner as the best available evidence of the re-establishment of the Original Corner.

- (3) C-1, T.18N., R.16W., Set 3" Harrison cast iron monument, East, 38.23'
- (4) Set 60d spike, NW side 36" Sugar Maple, S51°E, 48.58'
- (5) Existing 60d spike, NW side P.P. N41°E, 57.41'
- (6) Center 10" Locust (No spike set), N38°W, 79.00'
- (7) Set 60d spike, NW side 24" Sugar Maple, N75°E, 98.78'

Signed by [Signature] Date Nov. 4, 1999

Surveyor's Michigan License No. 17634

Approved by Peer Review Group on Nov. 4, 1999
Kenneth L. Ross, County Representative [Signature]

