

SURVEY & REMONUMENTATION

MAR 16 1998

LAND CORNER RECORDATION CERTIFICATE

SECTION

Filing Requirement of Act 74, Mich. P.A. 1970

For corners in Mason (County) Located In: _____ Corner Code # _____

1. Public Land Survey T 19N R 16W _____ D-1 _____
 T _____ R _____
 T _____ R _____
 T _____ R _____

2. Property Controlling S _____ T _____ R _____
 in Section S _____ T _____ R _____

3. Miscellaneous S _____ T _____ R _____
 Property in Sec. S _____ T _____ R _____

4. Lot No. _____ Recorded Plat _____

5. Private Claims _____

FILED

AT 4:05 O'CLOCK P M

NOV 20 1997

MARY GOLDEN KOLASKI
 MASON COUNTY
 REGISTER OF DEEDS

Register of Deeds Stamp & File Number

	A	B	C	D	E	F	G	H	I	J	K	L	M
1													
2	6			5		4		3		2		1	
3													
4	7			8		9		10		11		12	
5													
6	18			17		16		15		14		13	
7													
8	19			20		21		22		23		24	
9													
10	30			29		28		27		26		25	
11													
12	31			32		33		34		35		36	
13													

I, Richard L. Hays, in a field survey on August 1997, do hereby certify that under requirements of P.A. 74, Michigan P.A. of 1970, the corner points mentioned in lines 1 and 2 above were in conformance with regulations and rules therefore as required in the current manual of survey instructions of the United States Department of the Interior, Bureau of Land Management or by a decree of a Court of Law and/or that the corner points mentioned in lines 3, 4 and 5 above were in conformance with the rules of the Michigan Board of Land Surveyors or by a Decree of a Court of Law; established, re-established, monumented, re-monumented, recovered, found as expressed below:

NOTE: Not more than 4 corners, all in the same town and range, may be recorded on this certificate.

A. Description of original monument and accessories and/or subsequent restoration:
 D-1 NORTH QUARTER OF SECTION 5, T19N-R16W

G.L.O Survey:
 This Corner was not set by the G.L.O. Surveyor

1981: Ross Survey #17534
 Act 132, Liber 277, Page 457
 Set Closing Corner
 1/2" Re-Rod East 23.76' (1)


B. Description of corner evidence found and/or method applied in restoring or reestablishing corner:
 D-1 NORTH QUARTER OF SECTION 5, T19N-R16W

August 1997: Found 1/2" Re-Rod.
 Condition of the Witnesses are as follows:
 1/2" Re-Rod East 23.76' (1) (FOUND)

C. Description of monument for corner and accessories established to perpetuate locating the position of the corner:
 D-1 NORTH QUARTER OF SECTION 5, T19N-R16W

August 1997: Replace the 1/2" Re-Rod in the exact location with the Standard Mason County Monument. This Monument is accepted as the best available evidence of the position of Corner with the following Witnesses:

- 3/8" Rod N-59°-W 28.95'
- 3/8" Rod N-50°-E 33.04'
- Spike in the NE side of 3" Maple S-10°-E 48.62'
- Spike in the NW side of 6" Maple S-12°-W 46.26'
- Standard Corner West 23.76'
- Old Fence Line South

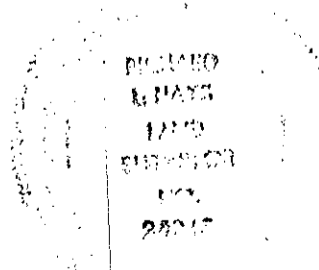

Signed by Richard Hays Date 11/6/97

Surveyor's Michigan License No. 25047

Peer Group Reviewed
 as Approved
 Date: Nov 2 1997
 Kenneth

FORM APPROVED BY MICHIGAN STATE BOARD OF LAND SURVEYORS, JAN. 28, 1971
 REVISED MAY 14, 1975
 REVISED JAN., 1983
 ADAPTED FOR WORD PROCESSING MARCH, 1993