

DEC 29 1993

LAND CORNER RECORDATION CERTIFICATE

Filing Requirement of Act 74, Mich. P.A. 1970

SECTION

For corners in

MASON (County)

Located In:

Corner Code #

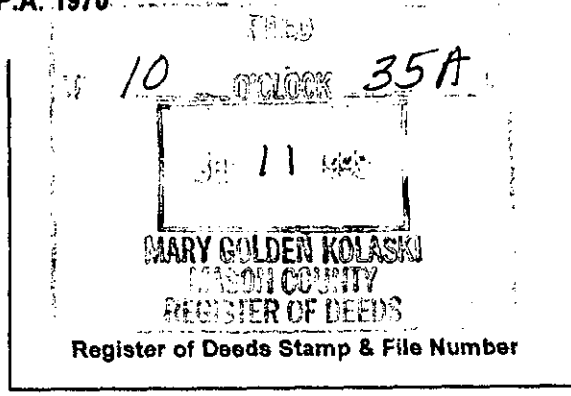


Table with 3 columns: Description, Located In (T, R, S, T, R), and Corner Code # (E-4).

4. Lot No. Recorded Plat
5. Private Claims

I, Kenneth L. Ross, in a field survey on August 25 19 98, do hereby certify that under requirements of P.A. 74, Michigan P.A. of 1970, the corner points mentioned in lines 1 and 2 above were in conformance with regulations and rules therefore as required in the current manual of survey instructions of the United States Department of the Interior, Bureau of Land Management or by a decree of a Court of Law and/or that the corner points mentioned in lines 3, 4 and 5 above were in conformance with the rules of the Michigan Board of Land Surveyors or by a Decree of a Court of Law, established, re-established, monumented, re-monumented, recovered, found as expressed below.

Grid table with columns A-M and rows 1-13. Cell (4,9) contains a black dot.

NOTE: Not more than 4 corners, all in the same town and range, may be recorded on this certificate.

A. Description of original monument and accessories and/or subsequent restoration:

E-4 1/4 Corner for Sections 8 and 9, T19N-R16W

1838, Sylvester Sibley, G.L.O. Set Wood post #1 Sugar Maple 10" S 21 W 19 lks. (12.54') #2 Black Ash 8" N 60 E 8 lks. (5.28')

1899, R.O. Towns, Mason Co. Surveyor Towns broke the South 1/2 of Section 8, Found Gov't witness tree still standing, gives a distance of 2640 ft. to the SE cor. monument not given, no new wit. were taken (book 4, page 6)

1989, Gordon Bonney, RLS #12016 (liber 3, page 4) set 1/2" re-rod at a double distance of 2622.00' from a found iron at 1311.00', South from the NE cor. Section 8, 19-16. #3 Ash 6" East 20.53' #4 Maple 28" N 85 W 24.76' #5 Ash 10" N 42 W 31.65'

1995, Kenneth Ross, RLS #17634 (file no. 95390s.) Set 1/2" Re-Rod w/ RLS cap at a single pro-rate, between controlling corners, to better fit historical surveys by G.L.O. and Towns, Ross measured a split distance of 2640.02', also checks well with G.L.O. creek call, South 396 feet, Ross measured 422 feet. Bonney's Iron is 17.81 feet to the North. #6 Elm 10" S 51 E 51.91' #7 Ash 6" N 71 E 43.79' #8 Maple 14" N 58 W 54.95' #9 Ash 10" S 49 W 42.53'

B. Description of corner evidence found and/or method applied in restoring or reestablishing corner:

E-4 1/4 Corner for Sections 8 and 9, T19N-R16W

On August 25, 1998, I found 1/2" Re-Rod set by me in previous survey, in the center line of Tuttle Road. I found no additional evidence to dispute this position four corner.

Condition of record witnesses are as follows; #1 Gone #2 Gone #3 Found in good condition to Bonney's corner #4 Found in good condition to Bonney's corner #5 Found in good condition to Bonney's corner #6 Found in good condition #7 Same as 3 #8 Found in good condition #9 Found in good condition


Note: Found an old fence line at South 1/16 line, at 1320 feet from E-4 and 1320 feet from E-5.

C. Description of monument for corner and accessories established to perpetuate locating the position of the corner:

E-4 1/4 Corner for Sections 8 and 9, T19N-R16W

I replaced 1/2" re-rod, in the exact location, with a Harrison cast iron, stamped MASON COUNTY MONUMENT, monument was set 1.0 foot below dirt road, at the center-line. This corner is accepted as a careful and faithful re-establishment of the position of the original corner.

Ext. "BT" #6 Elm 12" S 51 E 51.90' (60d spike in NE side of tree) Ext. "BT" #7 Ash 8" N 71 E 43.79' (60d spike in NW side of tree) Ext. "BT" #8 Maple 14" N 58 W 54.95' (60d spike in SW side of tree) Ext. "BT" #9 Ash 10" S 49 W 42.52' (60d spike in SE side of tree)

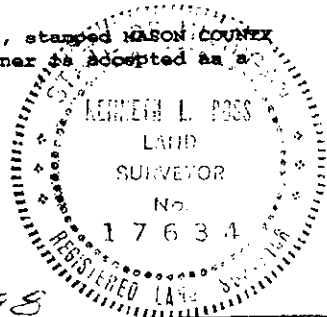

Signed by [Signature] Date Sept 5, 1998

Surveyor's Michigan License No. 17634

FORM APPROVED BY MICHIGAN STATE BOARD OF LAND SURVEYORS, JAN. 28, 1971 REVISED MAY 14, 1978 REVISED JAN. 1983 ADAPTED FOR WORD PROCESSING MARCH, 1983