

DEC 29 1998

SECTION

LAND CORNER RECORDATION CERTIFICATE

Filing Requirement of Act 74, Mich. P.A. 1970

For corners in MASON (County)

Located In:

Corner Code #

- 1. Public Land Survey T 19N R 16W E-5
2. Property Controlling in Section S T R
3. Miscellaneous Property in Sec. S T R

Register of Deeds Stamp & File Number. Includes handwritten 'FILED', '10 O'CLOCK 35 A', and '11 1998'.

4. Lot No. Recorded Plat
5. Private Claims

I, Kenneth L. Ross, in a field survey on August 25 19 98, do hereby certify that under requirements of P.A. 74, Michigan P.A. of 1970, the corner points mentioned in lines 1 and 2 above were in conformance with regulations and rules therefore as required in the current manual of survey instructions of the United States Department of the Interior, Bureau of Land Management or by a decree of a Court of Law and/or that the corner points mentioned in lines 3, 4 and 5 above were in conformance with the rules of the Michigan Board of Land Surveyors or by a Decree of a Court of Law, established, re-established, monumented, re-monumented, recovered, found as expressed below.

NOTE: Not more than 4 corners, all in the same town and range, may be recorded on this certificate.

A. Description of original monument and accessories and/or subsequent restoration:

E-5 Section Corner for Sections 8, 9, 16 and 17, T19N-R16W

1838, Sylvester Sibley, G.L.O. Set wood Post #1 Beech 10" N 59 W 19 lks. (12.54') #2 Beech 8" S 51 E 23 lks. (15.18') 1899, R. O. Towns, Mason Co. Surveyor Found G.L.O. witness #2 trees still standing, monument not given (book 4, page 6)

1956, Mason Co. Road Comm. Wood Stake and Iron #3 Tele. pole NE 35.00' #4 Fence corner post NW 31.4' #5 Fence corner post SW 33.00' (land corner card J-7) 1995, Kenneth Ross, RLS #17634 Found existing iron in paved road (file no. 95390s.)

Grid table with columns A-M and rows 1-13. Contains numbers 6-36 and a black dot in cell 5D.

B. Description of corner evidence found and/or method applied in restoring or reestablishing corner:

E-5 Section Corner for Sections 8, 9, 16 and 17, T19N-R16W

On August 25, 1998, I found a 3/4" Iron Rod, over a 3/4" Iron Pipe in the center-line of Fountain Road. I found no evidence to dispute this location for the corner.

Condition of record witnesses are as follows: #1 Gone #2 Gone #3 Gone #4 Gone #5 Gone

C. Description of monument for corner and accessories established to perpetuate locating the position of the corner:


E-5 Section Corner for Sections 8, 9, 16 and 17, T19N-R16W

I replaced both found Irons, in the exact location, with a Harrison cast iron monument, stamped MASON COUNTY MONUMENT, set flush with the pavement of the road, encased in concrete. This corner is accepted as a careful and faithful re-establishment of the position of the original corner. I took four new witness.

- #6 Stop Sign N 25 W 42.08' (center of post)
#7 Power-pole N 46 E 49.47' (p. k. nail in NW side of pole)
#8 Tele-phone Junc. Box S 41 E 54.66' (top center)
#9 Wood Post 6" x 8" S 49 W 47.44' (p. k. nail in SE side of post)

Signed by [Signature] Surveyor's Michigan License No. 17634

Date Sept 8, 1998

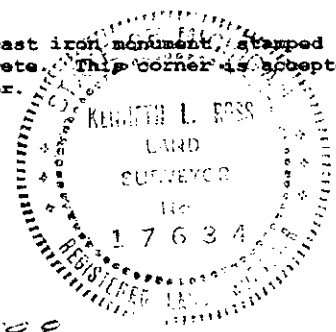

Handwritten signature and date at bottom right.