

SURVEY & MONUMENTATION


OCT 29 1996

COMMISSION

LAND CORNER RECORDATION CERTIFICATE
Filing Requirement of Act 74, Mich. P.A. 1970

For corners in

<u>MASON</u> (County)	Located In:	Corner Code #
1. Public Land Survey	T <u>19</u> N R <u>16</u> W	E-08
	T _____ R _____	_____
	T _____ R _____	_____
	T _____ R _____	_____
2. Property Controlling in Section	S _____ T _____ R _____	_____
	S _____ T _____ R _____	_____
3. Miscellaneous Property in Sec.	S _____ T _____ R _____	_____
	S _____ T _____ R _____	_____
4. Lot No. _____, Recorded Plat _____		
5. Private Claims _____		

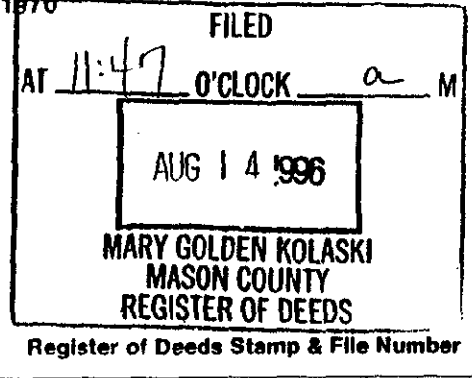

A	B	C	D	E	F	G	H	I	J	K	L	M
2	6	5	4	3	2	1						
3												
4	7	8	9	10	11	12						
5												
6	18	17	16	15	14	13						
7												
8	19	20	21	22	23	24						
9												
10	30	29	28	27	26	25						
11												
12	31	32	33	34	35	36						
13												

I, Sammy S. Barnett, in a field survey on July 11, 1996, do hereby certify that under requirements of P.A. 74, Michigan P.A. of 1970, the corner points mentioned in lines 1 and 2 above were in conformance with regulations and rules therefore as required in the current manual of survey instructions of the United States Department of the Interior, Bureau of Land Management or by a decree of a Court of Law and/or that the corner points mentioned in lines 3, 4 and 5 above were in conformance with the rules of the Michigan Board of Land Surveyors or by a Decree of a Court of Law; established, re-established, monumented, re-monumented, recovered, found as expressed below:

NOTE: Not more than 4 corners, all in the same town and range, may be recorded on this certificate.

A. Description of original monument and accessories and/or subsequent restoration:
 E-08 1/4 Corner for Sections 20 and 21, T19N, R16W.
Sylvester Sibley, 1838, G.L.O.
 Set Wood Post
 #1 Hemlock 16" N73°E 171ks. (11.22')
 #2 Cedar 14" S14°W 111ks. (7.26')
R.O. Towns, MCS, 1902
 Iron
 no new witnesses

B. Description of corner evidence found and/or method applied in restoring or reestablishing corner:
 E-08 1/4 Corner for Sections 20 and 21, T19N, R16 W.
 On July 11, I found a 3" x 18" strap Iron at the intersection of Mavis and Tuttle Roads, 0.5 foot below road surface. I found no evidence to dispute this location for the corner.
 Condition of recorded witnesses are;
 #1 Gone
 #2 Gone

C. Description of monument for corner and accessories established to perpetuate locating the position of the corner:
 E-08 1/4 Corner for Sections 20 and 21, T19N, R16W.
 I replaced existing strap iron, in the exact location, with a standard Mason County Monument, placed 1.0 foot below road surface, and is accepted as a careful and faithful reestablishment of the position of the original corner.
 (ext. BT) Maple 6" N 20° W 77.74' (16p w/ shiner in NE side of tree)
 (ext. BP) Power Pole S 73° W 74.52' (16p w/ shiner in SE side of Pole)
 W. Cherry 7" S 23° W 88.30' (60d spike in SE side of tree)
 "I" Beam SW corner Center-east side of Bridge N 30° E 28.87'

Signed by Sammy S. Barnett Date 8-12-96
 Surveyor's Michigan License No. 16923
 Peer Group Reviewed and Approved
 Date: 8-12-96
Kenneth L. Ross
 Mason County Surveyor



FORM APPROVED BY MICHIGAN STATE BOARD OF LAND SURVEYORS, JAN. 28, 1971
 REVISED MAY 14, 1975
 REVISED JAN., 1983