


SECTION

LAND CORNER RECORDATION CERTIFICATE
Filing Requirement of Act 74, Mich. P.A. 1970

For corners In: Located In: Corner Code #
Mason County
1. Public Land Survey T 19N R 16W E-13
2. Property Controlling in Section S T R
3. Miscellaneous S T R
Property in Sec. S T R

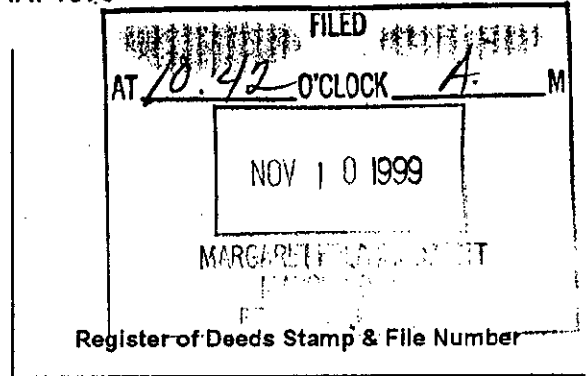

4. Lot No. Recorded Plat
5. Private Claims

I, Kenneth L. Ross, in a field survey on September 11, 1999, Do hereby certify that under requirements of P.A.74, Michigan P.A. of 1970, the corner points mentioned in lines 1 and 2 above were in conformance with regulations and rules therefore as required in the current manual of survey instructions of the United States Department of the Interior, Bureau of Land Management or by a decree of a Court of Law and/or that the corner points mentioned in lines 3, 4 and 5 above were in conformance with the rules of the Michigan Board of Land Surveyors or by a Decree of a Court of Law; established, re-established, monumented, re-monumented, recovered, found as expressed below:

Table with 13 rows and 13 columns (A-M) containing numbers 1-36 in a grid pattern.

NOTE: Not more than 4 corners, all in the same town and range, may be recorded on this certificate.

A. Description of original monument and accessories and/or subsequent restoration:

Corner Common to Sections 32 & 33, T.19N., R.16W.,

GLO Mullett and Brookfield, 1838
"Set Post Common to Sections 32 & 33"
(1) Beech, 6", N66°W, 12 links, (7.92')
(2) Hemlock, 18", N44°E, 17 links, (11.22')

Peter Eastman, 1876, Book 1, page 26 & 27
"Corner marked by Govt. Witnesses"
No new Witnesses Given.
Distance West to D-13, 2603.04'
Distance North to E-12, 2613.60'

R.O. Towns, 1903, Book 2, page 184
"Stone for Corner" No Witnesses Given.
Distance West to D-13, 2622.84'
Distance North to E-12, 2624.16'

Dennis Dunlap, 1980, Act 132
"Fd. 1/2" iron, 29.88' West of E-1,
T.18N., R.16W.,
(3) T.P. N30°E, 71.57'
(4) 24" W. Pine, S30°W, 53.89'
(5) Pine, S70°W, 88.52'

K.L. Ross, Act 132, 1984,
"Existing iron 30' West of E-1
T.18N., R.16W., No Witnesses Given.
Distance West to C-13, 5259.10'
Distance North to E-12, 2627.64'

K.L. Ross, Act 132, 1984,
"Fd. Iron 30' West of E-1,
T.18N., R.16W., No Witnesses Given.
Distance East to F-13, 2641.97'

K.L. Ross, Act 132, 1992
"Fd. 1/2" iron rod"
(6) P.P. N73°E, 71.59'
(7) 5/8" iron rod, East, 29.92'
(8) Rd Name sign, N10°W, 31.93'

B. Description of corner evidence found and/or method applied in restoring or reestablishing corner:

Corner Common to Sections 32 & 33, T.19N., R.16W.,

I found a 1/2" X 15" re-rod on East side of Large stone (believed to be that as described by R.O. Towns) in the center-line of Decker Road and about 8" below the gravel surface. Witnesses (1) through (4) have been destroyed. Witnesses (5) through (8) are standing and in good condition. I found no other evidence to dispute the location of this corner.

C. Description of monument for corner and accessories established to perpetuate locating the position of the corner:

Corner Common to Sections 32 & 33, T.19N., R.16W.,

I replaced the 1/2" X 15" iron re-rod in its exact location with a 5/8" X 24" Iron re-rod with a standard 3" aluminum cap stamped "Mason County Monument", 8 inches below the gravel surface and on the center-line of Decker Road and accepted this corner as the best available evidence of the re-establishment of the Original Corner.

- (6) Existing 60d spike NW side of P.P. N67°E, 71.65'
(5) Existing 60d spike North side of 15" Jack Pine, S75°W, 88.48'
(7) E-1, T.18N., R.16W., Set 5/8" X 24" re-rod with 3" Aluminum Cap, East, 29.95'
(8) Center of 2" diameter Street Sign Post, N11°W, 31.94
(9) Existing 60d spike, East side of 30" White Pine, S03°E, 53.12' (Possibly Witness (4) above ??
Center-line Tuttle Road, East, 30'

Signed by [Signature] Date Nov 4, 1999

Surveyor's Michigan License No. 17634

Approved by Peer Review Group on Nov 4, 1999
Kenneth L. Ross, County Representative [Signature]

