

SURVEY & REMONUMENTATION

MAR 16 1998

LAND CORNER RECORDATION CERTIFICATE

Filing Requirement of Act 74, Mich. P.A. 1970

SECTION
For corners in


Mason
(County)

Located In: _____ Corner Code # _____

1. Public Land Survey T 19N R 16W _____ F-1
 T _____ R _____
 T _____ R _____
 T _____ R _____

2. Property Controlling S _____ T _____ R _____
 in Section S _____ T _____ R _____

3. Miscellaneous S _____ T _____ R _____
 Property in Sec. S _____ T _____ R _____

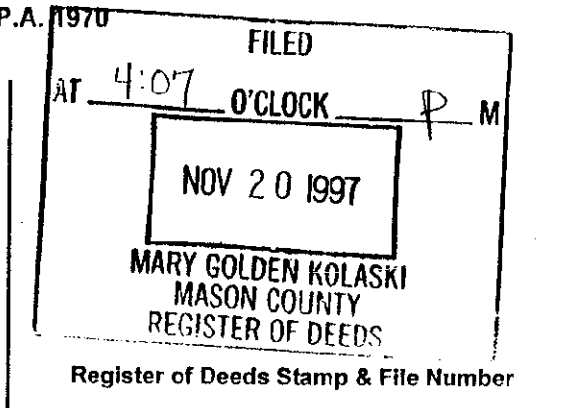

4. Lot No. _____ Recorded Plat _____
5. Private Claims _____

	A	B	C	D	E	F	G	H	I	J	K	L	M
1													
2	6	5	4	3	2	1							
3													
4	7	8	9	10	11	12							
5													
6	18	17	16	15	14	13							
7													
8	19	20	21	22	23	24							
9													
10	30	29	28	27	26	25							
11													
12	31	32	33	34	35	36							
13													

I, Richard L. Hays, in a field survey on August 1997, do hereby certify that under requirements of P.A. 74, Michigan P.A. of 1970, the corner points mentioned in lines 1 and 2 above were in conformance with regulations and rules therefore as required in the current manual of survey instructions of the United States Department of the Interior, Bureau of Land Management or by a decree of a Court of Law and/or that the corner points mentioned in lines 3, 4 and 5 above were in conformance with the rules of the Michigan Board of Land Surveyors or by a Decree of a Court of Law; established, re-established, monumented, re-monumented, recovered, found as expressed below:

NOTE: Not more than 4 corners, all in the same town and range, may be recorded on this certificate.

- A. Description of original monument and accessories and/or subsequent restoration:
 F-1 NORTH QUARTER CORNER OF SECTION 04, T19N-R16W
 G.L.O Survey:
 This Corner was not set in the Original G.L.O Survey
- B. Description of corner evidence found and/or method applied in restoring or reestablishing corner:
 F-1 NORTH QUARTER CORNER OF SECTION 04, T19N-R16W
 August 1997: No Evidence of Corner was found. Corner was re-established by proportionate measurement between the closing corners and on line between the Standard Corners.
- C. Description of monument for corner and accessories established to perpetuate locating the position of the corner:
 F-1 NORTH QUARTER CORNER OF SECTION 04, T19N-R16W
 August 1997: Set a Standard Mason County Monument. This position was not established by the Original Government Surveyor. This monument is accepted as a careful and faithful establishment of the position of the Corner with the following Witnesses:
- | | | |
|------------------|---------|----------|
| 3/8" Rod | S-32°-E | 12.76' |
| 3/8" Rod | S-72°-W | 26.03' |
| 3/8" Rod | N-50°-W | 26.87' |
| 3/8" Rod | N-10°-W | 13.60' |
| Standard Corner | West | 16.12' |
| G-1 | East | 2636.39' |
| E-1 | West | 2636.39' |
| Northwest Corner | West | 2636.39' |
| Northeast Corner | East | 2636.39' |

Signed by Richard Hays Date 11/6/97
 Surveyor's Michigan License No. 25847

Date: Nov. 21, 1997
[Signature]