

DEC 29 1998

LAND CORNER RECORDATION CERTIFICATE

Filing Requirement of Act 74, Mich. P.A. 1970

SECTION


For corners in

MASON  
(County)

Located In:

Corner Code #

- 1. Public Land Survey T 19N R 16W F-3
- T \_\_\_\_\_ R \_\_\_\_\_
- T \_\_\_\_\_ R \_\_\_\_\_
- T \_\_\_\_\_ R \_\_\_\_\_
- 2. Property Controlling S T R
- In Section S T R
- 3. Miscellaneous S T R
- Property in Sec. S T R

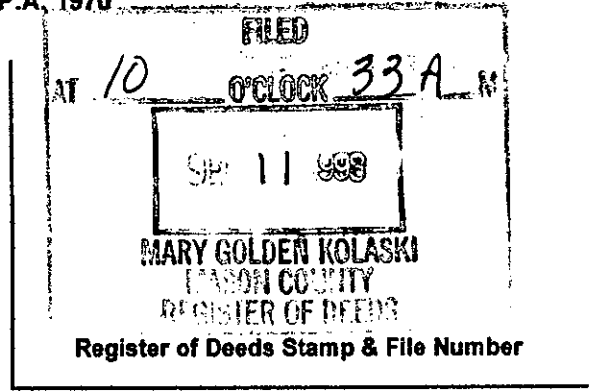

- 4. Lot No. \_\_\_\_\_, Recorded Plat \_\_\_\_\_
- 5. Private Claims \_\_\_\_\_

	A	B	C	D	E	F	G	H	I	J	K	L	M
1													
2	6	5	4	3	2	1							
3													
4	7	8	9	10	11	12							
5													
6	18	17	16	15	14	13							
7													
8	19	20	21	22	23	24							
9													
10	30	29	28	27	26	25							
11													
12	31	32	33	34	35	36							
13													

I, Kenneth L. Ross, in a field survey on June 22 1998, do hereby certify that under requirements of P.A. 74, Michigan P.A. of 1970, the corner points mentioned in lines 1 and 2 above were in conformance with regulations and rules therefore as required in the current manual of survey instructions of the United States Department of the Interior, Bureau of Land Management or by a decree of a Court of Law and/or that the corner points mentioned in lines 3, 4 and 5 above were in conformance with the rules of the Michigan Board of Land Surveyors or by a Decree of a Court of Law, established, re-established, monumented, re-monumented, recovered, found as expressed below:

NOTE: Not more than 4 corners, all in the same town and range, may be recorded on this certificate.

A. Description of original monument and accessories and/or subsequent restoration:

F-3 1/4 Corner for Section 4 and 9, T19N-R16W.

1838, Sylvester Sibley, G.L.O.  
Set Wood Post at 39.88 chs. (2632.08')  
#1 Hemlock 14" N 31 E 113 lks. (74.58')  
#2 Hemlock 16" S 05 W 34 lks. (22.44')

1986, Clint Cole, RLS #17615  
Set 1/2" Re-Rod at a single pro-rate, between controlling corners, at 2662.90' (liber 340, page 901)  
#3 Cherry 7" S 34 W 36.24'  
#4 Power Pole N 32 W 45.02'  
#5 Red Pine 6" N 25 E 47.06'

B. Description of corner evidence found and/or method applied in restoring or reestablishing corner:

F-3 1/4 Corner for Section 4 and 9, T19N-R16W.

On June 22, 1998, I found 1/2" Re-Rod with RLS yellow cap, set by Clint Cole, corner is in Bayer Road, (earthen surface), also found Cole Re-Rod 33.00 feet South at R.O.W., I found no evidence to dispute this location for the corner.

Condition of record witnesses are as follows: #1 Gone #2 Gone #3 Found in good condition

#4 Found in good condition #5 Found stump, tree as been cut off.

C. Description of monument for corner and accessories established to perpetuate locating the position of the corner:


F-3 1/4 Corner for Section 4 and 9, T19N-R16W.

I replaced 1/2" Re-Rod, with RLS yellow cap, in the exact location, with a Harrison cast iron monument, that is stamped, MASON COUNTY MONUMENT, monument was placed 0.5 feet below road surface. This corner is accepted as a careful and faithful re-establishment of the position of the original corner.

- Ext. "BT" #3 Cherry 9" S 34 W 36.22' (16p nail in the SE side of tree)
- Ext. "BP" #4 Power Pole N 32 W 45.02' (16p nail in the NE side of tree)
- New "BT" #6 White Pine 6" N 23 W 65.20' (60d spike in the NW side of tree)
- New "BT" #7 Red Pine 7" N 28 E 66.94' (60d spike in the NW side of tree)

Signed by Kenneth L. Ross  
Surveyor's Michigan License No. 17634

Date Sept 8, 1998

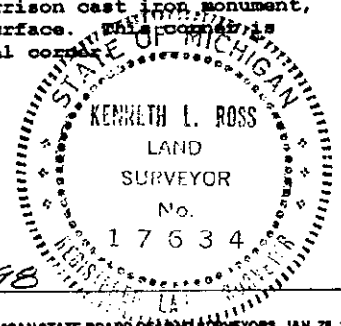

FORM APPROVED BY MICHIGAN STATE BOARD OF LAND SURVEYORS, JAN. 28, 1971  
REVISED MAY 14, 1975  
REVISED JAN., 1983  
ADAPTED FOR WORD PROCESSING MARCH 1993

Mason County Surveyor  
Peer Group Reviewed and Approved  
Date: 9-8-98  
Kenneth L. Ross  
Mason County Surveyor