

FEB 08 2000


LAND CORNER RECORDATION CERTIFICATE

Filing Requirement of Act 74, Mich. P.A. 1970

SECTION

For corners In: Located In: Corner Code #
Mason County

- 1. Public Land Survey T 19N R 16W F-13
- 2. Property Controlling in Section S _____ T _____ R _____
- 3. Miscellaneous S _____ T _____ R _____
- Property in Sec. S _____ T _____ R _____
- 4. Lot No. _____, Recorded Plat _____
- 5. Private Claims _____

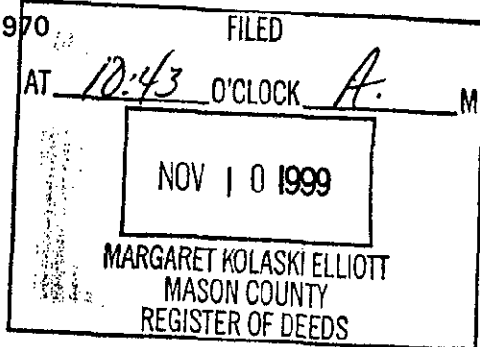

Register of Deeds Stamp & File Number

	A	B	C	D	E	F	G	H	I	J	K	L	M
2	6	5	4	3	2	1							
4	7	8	9	10	11	12							
6	18	17	16	15	14	13							
8	19	20	21	22	23	24							
10	30	29	28	27	26	25							
12	31	32	33	34	35	36							

Kenneth L. Ross, in a field survey on September 11, 1999, Do hereby certify that under requirements of P.A.74, Michigan P.A. of 1970, the corner points mentioned in lines 1 and 2 above were in conformance with regulations and rules therefore as required in the current manual of survey instructions of the United States Department of the Interior, Bureau of Land Management or by a decree of a Court of Law and/or that the corner points mentioned in lines 3, 4 and 5 above were in conformance with the rules of the Michigan Board of Land Surveyors or by a Decree of a Court of Law; established, re-established, monumented, re-monumented, recovered, found as expressed below:

NOTE: Not more than 4 corners, all in the same town and range, may be recorded on this certificate.

A. Description of original monument and accessories and/or subsequent restoration:

3/4 Corner Section 33, T.19N., R.16W.,

GLO Mullett and Brookfield, 1838
"Set quarter Section Post"

- (1) Sugar, 9", N36°W, 12 links (7.92')
- (2) Beech, 18", S62°E, 45 links (29.70')

K.L. Ross, Act 132, 1984
"Found Iron" No Witnesses Given
Distance West to E-13, 2641.97'

Dennis Dunlap, Act 132, 1980,

- "reset corner with 1/2" re-bar"
- (3) X in bolder, S25°E, 62.99'
- (4) Nail in P.P. N70°W, 69.69'
- (5) Nail in Fence Post, N65°E, 209.47'
- Distance West to E-13, 2642.26'
- Distance East to G-13, 2642.26'

B. Description of corner evidence found and/or method applied in restoring or reestablishing corner:

3/4 Corner Section 33, T.19N., R.16W.,

I found a 1/2" X 24" re-bar as described by Dunlap above, 2" below the road surface and 5' south of the center-line of Decker Road. Witnesses (1) through (5) have been destroyed. I found no other evidence to dispute the location of this corner.

C. Description of monument for corner and accessories established to perpetuate locating the position of the corner:

3/4 Corner Section 33, T.19N., R.16W.,


I replaced the 1/2" X 24" re-rod in the exact location with a Standard 3" Cast Iron Harrison Monument stamped "Mason County Monument" 5 foot south of the center-line of Decker Road and 1 foot below the surface. This corner accepted as the best available evidence of the re-establishment of the position of the original corner.

- (6) Existing 60d spike NE side of 18" Ash, N84°E, 113.14'
- (7) Set 60d spike NW side of Gate Post, N79°E, 83.40'
- (8) Set 60d spike West side of 8" Box Elder, S36°E, 46.40'
- (9) Iron and Cap #17634, North 33.00'
- (10) F-1, T.18N., R.16W., Set 3" Harrison Cast Iron Monument, East, 25.54'

Signed by [Signature] Date Nov. 4, 1999

Surveyor's Michigan License No. 17634

Approved by Peer Review Group on Nov. 4, 1999
Kenneth L. Ross, County Representative [Signature]

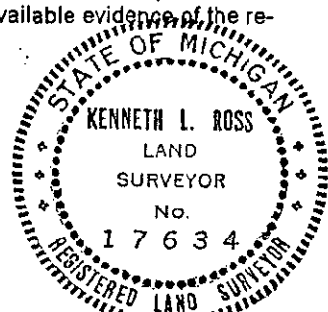

FORM APPROVED BY MICHIGAN STATE BOARD OF LAND SURVEYORS, JAN. 28, 1971
REVISED MAY 14, 1975
REVISED JAN, 1983
ADAPTED FOR WORD PROCESSING MARCH, 1993