

**SURVEY & REMONUMENTATION**

MAR 16 1998

**LAND CORNER RECORDATION CERTIFICATE**

Filing Requirement of Act 74, Mich. P.A. 1970

SECTION

For corners in

MASON


(County)

Located In:

Corner Code #

- 1. Public Land Survey T 19N R R16W G-01  
 T R  
 T R  
 T R
- 2. Property Controlling S T R  
 in Section S T R
- 3. Miscellaneous S T R  
 Property in Sec. S T R

- 4. Lot No. \_\_\_\_\_, Recorded Plat \_\_\_\_\_
- 5. Private Claims \_\_\_\_\_

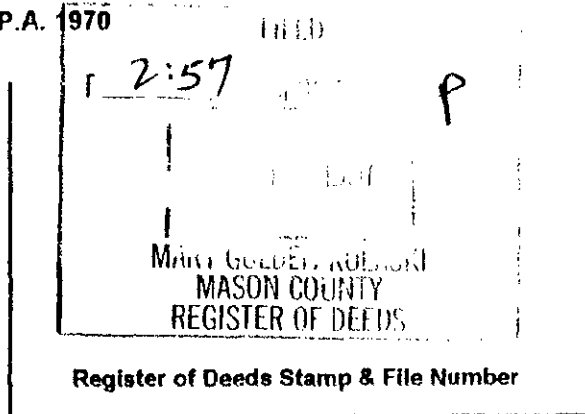

I, Kenneth L. Ross, in a field survey on October 27, 1997, do hereby certify that under requirements of P.A. 74, Michigan P.A. of 1970, the corner points mentioned in lines 1 and 2 above were in conformance with regulations and rules therefore as required in the current manual of survey instructions of the United States Department of the Interior, Bureau of Land Management or by a decree of a Court of Law and/or that the corner points mentioned in lines 3, 4 and 5 above were in conformance with the rules of the Michigan Board of Land Surveyors or by a Decree of a Court of Law; established, re-established, monumented, re-monumented, recovered, found as expressed below:

**NOTE: Not more than 4 corners, all in the same town and range, may be recorded on this certificate.**

A. Description of original monument and accessories and/or subsequent restoration:

G-01 Section Corner for Sections 3 and 4, on the Township line, T19N-16W.

1838, Sylvester Sibley, G.L.O.

Set Wood Post

- #1 Hemlock 12" S 14° E 26 lks. (17.16ft.)
- #2 Hemlock 8" S 36° W 55 lks. (36.30ft.)

1901, R. O. Towns, Mason County Surveyor

Found old stake for corner, used in Cadastral survey of Section 3, T19N-R16W. Book 2, Page 23

B. Description of corner evidence found and/or method applied in restoring or reestablishing corner:

G-01 Section Corner for Sections 3 and 4, on the Township line, T19N-16W.

On October 27, 1997, I Ken Ross and Kevin Pritchard (survey tech.) search for any evidence of a existing corner, but found no evidence of corner.

Condition of recorded witnesses are: #1 Gone #2 Gone

C. Description of monument for corner and accessories established to perpetuate locating the position of the corner:

G-01 Section Corner for Sections 3 and 4, on the Township line, T19N-16W.

I set this corner at G.L.O. recorded distance from standard corner, which was existing (page 257 G.L.O. field notes), corner was set on a straight line between controlling corners G-13 and H-13, T20N-R16W, I set a standard Mason County Monument (5/8" re-rod, 24" long, with a 2 1/2" aluminum cap, stamped to identify the corner. G-13, measures 13.86 feet West. And is accepted as a careful and faithful re-establishment of the position of the original corner.

- Poplar 12" N 52° W 112.88 ft. (60d spike in SW side of tree)
- Power Pole N 13° E 99.45 ft. (60d spike in NE side of tree)
- Support Post - Tele Junc. Box S 45° W 89.90 ft. (60d spike in NW side of pole)
- South 1/4 corner for Section 34, T20N-R16W East 2629.79 ft.

Signed by [Signature]

Date Nov. 9, 1997

Surveyor's Michigan License No. 17634

FORM APPROVED BY MICHIGAN STATE BOARD OF LAND SURVEYORS, JAN. 28, 1971  
 REVISED MAY 14, 1975  
 REVISED JAN., 1983  
 ADAPTED FOR WORD PROCESSING MARCH, 1993

Peer Group Reviewed and Approved  
 Date: Nov. 9, 1997  
[Signature]  
 Kenneth L. Ross  
 Mason County Surveyor

LIBER

4 PAGE 140

	A	B	C	D	E	F	G	H	I	J	K	L	M
1													
2	6	5	4	3	2	1							
3													
4	7	8	9	10	11	12							
5													
6	18	17	16	15	14	13							
7													
8	19	20	21	22	23	24							
9													
10	30	29	28	27	26	25							
11													
12	31	32	33	34	35	36							
13													

