

OCT 2 8 1996

COMMISSION

LAND CORNER RECORDATION CERTIFICATE

Filing Requirement of Act 74, Mich. P.A. 1970

FILED  
AT 9:44 O'CLOCK a M  
AUG 20 1996  
MARY GOLDEN KOLASKI  
MASON COUNTY  
REGISTER OF DEEDS

For corners in Mason Located In: \_\_\_\_\_ Corner Code # \_\_\_\_\_  
(County)

1. Public Land Survey T 19N R 16W G-05  
T \_\_\_\_\_  
T \_\_\_\_\_  
T \_\_\_\_\_

2. Property Controlling S \_\_\_\_\_ T \_\_\_\_\_ R \_\_\_\_\_  
in Section S \_\_\_\_\_ T \_\_\_\_\_ R \_\_\_\_\_

3. Miscellaneous S \_\_\_\_\_ T \_\_\_\_\_ R \_\_\_\_\_  
Property in Sec. S \_\_\_\_\_ T \_\_\_\_\_ R \_\_\_\_\_

4. Lot No. \_\_\_\_\_ Recorded Plat \_\_\_\_\_

5. Private Claims \_\_\_\_\_

Register of Deeds Stamp & File Number

I, Kenneth L. Ross, in a field survey on August 7, 1996, do hereby certify that under requirements of P.A. 74, Michigan P.A. of 1970, the corner points mentioned in lines 1 and 2 above were in conformance with regulations and rules therefore as required in the current manual of survey instructions of the United States Department of the Interior, Bureau of Land Management or by a decree of a Court of Law and/or that the corner points mentioned in lines 3, 4 and 5 above were in conformance with the rules of the Michigan Board of Land Surveyors or by a Decree of a Court of Law, established, re-established, monumented, re-monumented, recovered, found as expressed below:

	A	B	C	D	E	F	G	H	I	J	K	L	M
1													
2	6	5	4	3	2	1							
3													
4	7	8	9	10	11	12							
5				*									
6	18	17	16	15	14	13							
7													
8	19	20	21	22	23	24							
9													
10	30	29	28	27	26	25							
11													
12	31	32	33	34	35	36							
13													


NOTE: Not more than 4 corners, all in the same town and range, may be recorded on this certificate.

A. Description of original monument and accessories and/or subsequent restoration:  
G-5 Sec. Cor., 9, 10, 15, & 16-19-16  
1838 Sylvester Sibley  
(1) 16" Beech S 56 W 70 lks  
(2) 12" Beech N 45 E 8 lks

B. Description of corner evidence found and/or method applied in restoring or reestablishing corner:  
G-5 Sec. Cor., 9, 10, 15, & 16-19-16  
Aug., 1903, R. O. Towns Fd. Old Pump (Book 2, Page 179-180, County Surveyor's Records)  
Sep., 1903, R. O. Towns Fd. Old Pump (Book 4, Page 104-105, County Surveyor's Records)  
Jun., 1975, K. Ross Set PK over Iron  
(3) SW Cor. Tel. Office N 50 E 85.82'  
(4) Rd. Name Sign N 45 E 52.75'  
(5) P.P. N 50 W 39.90'  
May, 1976, K. Ross used corner in survey  
Aug., 1996, K. Ross Fd. PK over Carriage Bolt over 1" Iron Bar, CL Roads N-S & E-W

C. Description of monument for corner and accessories established to perpetuate locating the position of the corner:  
G-5 Sec. Cor., 9, 10, 15, & 16-19-16  
Fd. Witness #3 (dist. 85.61').  
Witness #1, 2, 4, & 5 gone.  
Replaced PK, Carriage Bolt, & 1" Iron Bar with 5/8" x 24" re-bar with 2 1/2" alum. cap in monument box, and is accepted as the best available evidence of the original corner.  
(6) USGS Marker U-24 N 16 W 98.77'  
(7) Power Pole S 14 E 111.78'  
(8) Power Pole S 47 W 48.62'  
(9) Power Pole N 47 W 40.23'

Signed by Kenneth L. Ross Date Aug 12, 1996

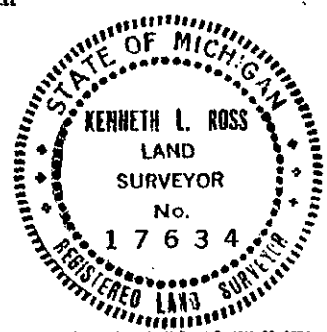

Surveyor's Michigan License No. 17634

Peer Group Reviewed and Approved  
Date: 8-13-96  
Kenneth L. Ross  
Mason County Surveyor