


SURVEY &
REMONUMENTATION

OCT 29 1996

COMMISSION

LAND CORNER RECORDATION CERTIFICATE

Filing Requirement of Act 74, Mich. P.A. 1970

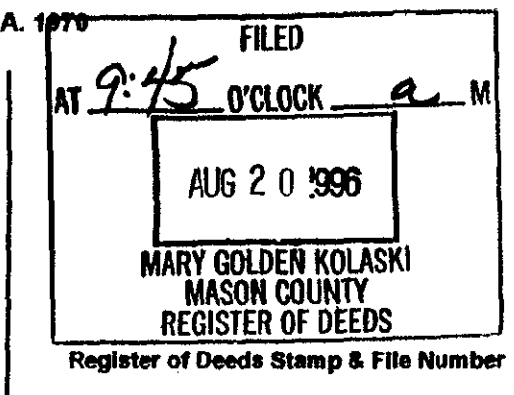

For corners in
Mason
(County)

Located In: _____ Corner Code # _____

1. Public Land Survey T 19N R 16W G-06
T _____ R _____
T _____ R _____
T _____ R _____

2. Property Controlling S _____ T _____ R _____
In Section S _____ T _____ R _____

3. Miscellaneous S _____ T _____ R _____
Property in Sec. S _____ T _____ R _____

4. Lot No. _____ Recorded Plat _____

5. Private Claims _____

I, Kenneth L. Ross, in a field survey on August 7, 1996, do hereby certify that under requirements of P.A. 74, Michigan P.A. of 1970, the corner points mentioned in lines 1 and 2 above were in conformance with regulations and rules therefore as required in the current manual of survey instructions of the United States Department of the Interior, Bureau of Land Management or by a decree of a Court of Law and/or that the corner points mentioned in lines 3, 4 and 5 above were in conformance with the rules of the Michigan Board of Land Surveyors or by a Decree of a Court of Law, established, re-established, monumented, re-monumented, recovered, found as expressed below:

NOTE: Not more than 4 corners, all in the same town and range, may be recorded on this certificate.

A. Description of original monument and accessories and/or subsequent restoration:

- G-6 1/4 Cor., 15 & 16-19-16
1838 Sylvester Sibley
(1) 16" Beech S 30 W 9 lks
(2) 10" Hemlock S 38 E 4 lks

B. Description of corner evidence found and/or method applied in restoring or reestablishing corner:

- G-6 1/4 Cor., 15 & 16-19-16
Aug., 1903, R. O. Towns Fd. Pump Handle (Book 2, Page 179-180, County Surveyor's Records)
Sep., 1903, R. O. Towns Fd. Pump Handle (Book 4, Page 104-105, County Surveyor's Records)
Aug., 1996, K. Ross Fd. 1/2" Re-bar next to 3/4" Square Iron Re-bar, 1.5' East of CL Road N-S, CL Road West


C. Description of monument for corner and accessories established to perpetuate locating the position of the corner:

- G-6 1/4 Cor., 15 & 16-19-16
Witness #1 & 2 gone.
Replaced 1/2" Re-bar & 3/4" Square Iron with 5/8" x 24" re-bar with 2 1/2" alum. cap in monument box and is accepted as the best available evidence of the original corner.
(3) Power Pole N 60 W 48.75'
(4) Power Pole N 87 E 31.66'
(5) Yield Sign S 85 W 70.55'
(6) CL Phone Box N 87 E 27.59'
(7) 4" Walnut N 26 W 90.03'

	A	B	C	D	E	F	G	H	I	J	K	L	M
1													
2	6	5	4	3	2	1							
3													
4	7	8	9	10	11	12							
5													
6	18	17	16	X 15	14	13							
7													
8	19	20	21	22	23	24							
9													
10	30	29	28	27	26	25							
11													
12	31	32	33	34	35	36							
13													

Signed by Kenneth L. Ross Date 8-12-96

Surveyor's Michigan License No. 17634

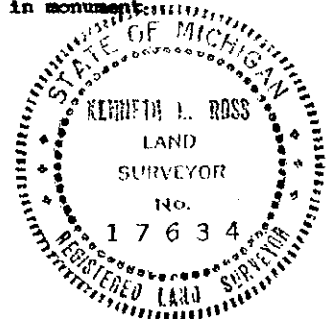

Peer Group Reviewed and Approved
Date: 8-13-96
Kenneth L. Ross
Mason County Surveyor