

FEB 08 2000


SECTION

LAND CORNER RECORDATION CERTIFICATE

Filing Requirement of Act 74, Mich. P.A. 1970

For corners In: Located In: Corner Code #
Mason County

- 1. Public Land Survey T 19N R 16W G-13
- 2. Property Controlling in Section S _____ T _____ R _____
- 3. Miscellaneous S _____ T _____ R _____
- Property in Sec. S _____ T _____ R _____
- 4. Lot No. _____, Recorded Plat _____
- 5. Private Claims _____

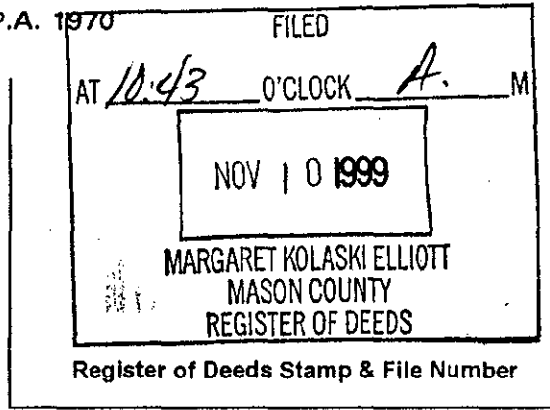

	A	B	C	D	E	F	G	H	I	J	K	L	M
1													
2	6	5	4	3	2	1							
3													
4	7	8	9	10	11	12							
5													
6	18	17	16	15	14	13							
7													
8	19	20	21	22	23	24							
9													
10	30	29	28	27	26	25							
11													
12	31	32	33	34	35	36							
13													

I, Kenneth L. Ross, in a field survey on September 11, 1999, Do hereby certify that under requirements of P.A. 74, Michigan P.A. of 1970, the corner points mentioned in lines 1 and 2 above were in conformance with regulations and rules therefore as required in the current manual of survey instructions of the United States Department of the Interior, Bureau of Land Management or by a decree of a Court of Law and/or that the corner points mentioned in lines 3, 4 and 5 above were in conformance with the rules of the Michigan Board of Land Surveyors or by a Decree of a Court of Law, established, re-established, monumented, re-monumented, recovered, found as expressed below:

NOTE: Not more than 4 corners, all in the same town and range, may be recorded on this certificate.

A. Description of original monument and accessories and/or subsequent restoration:

Corner Common to Sections 33 and 34, T.19N., R.16W.,

- GLO, Mullett and Brookfield, 1838
- *Set Post Corner Sections 33 and 34
- (1) Beech, 20", N73°W, 41 links, (27.06')
- (2) Beech, 7", N60°E, Distance unreadable
- Dennis Dunlap, Act 132, 1980
- "Found Iron, G-1, T.18N., R.16W., East 26.50"
- (3) 24" Apple, S60°W, 87.42'
- (4) T.P. N30°W, 33.21'
- (5) T.P., N50E, 60.48'
- (6) 30" Maple, S20°W, 153.68'

B. Description of corner evidence found and/or method applied in restoring or reestablishing corner:


Corner Common to Sections 33 and 34, T.19N., R.16W.,

I found a 12" Tent Stake inside a Monument Box, Witnesses (1), (2), (5) and (6) have been destroyed. Witnesses (3) and (4) are standing and in good condition. I could find no other evidence to dispute the location of this corner.

C. Description of monument for corner and accessories established to perpetuate locating the position of the corner:

Corner Common to Sections 33 and 34, T.19N., R.16W.,

- I replaced the 12" Tent Stake in its exact location with a 5/8" X 24" iron re-rod with a standard 3" aluminum cap stamped "Mason County Monument", inside the Monument Box in the center-line of Decker Road and about 6" below the Bituminous surface of Decker Road and accepted this corner as the best available evidence of the re-establishment of the Original Corner.
- (3) Existing 60d spike, NW side of 28" Apple, S70°W, 87.51'
- (4) Existing 60d spike NE side of Tel Service Pole, N20°W, 33.25'
- (7) Set 60d spike NW side of P.P. N64°E, 61.94'
- (8) Set 60d spike NE side of Guy Pole, N22°W, 50.82'
- (9) G-1, T.18N., R.16W., Set 5/8" X 24" re-rod with 3" Aluminum Cap, East 26.45' Center-line Custer Road, East 26.5'

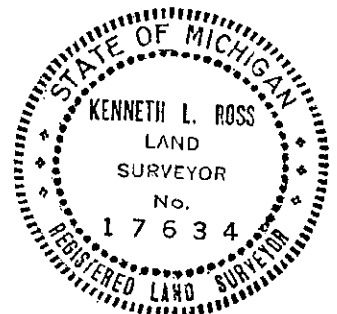

Signed by [Signature] Date Nov. 4, 1999

Surveyor's Michigan License No. 17634

Approved by Peer Review Group on Nov. 4, 1999
Kenneth L. Ross, County Representative [Signature]