

MAR 16 1998

LAND CORNER RECORDATION CERTIFICATE

Filing Requirement of Act 74, Mich. P.A. 1970

SECTION

For corners in


Mason (County)

Located In:

Corner Code #

- 1. Public Land Survey T 19N R 16W H-1
2. Property Controlling in Section S T R
3. Miscellaneous S T R Property in Sec. S T R

- 4. Lot No. Recorded Plat
5. Private Claims

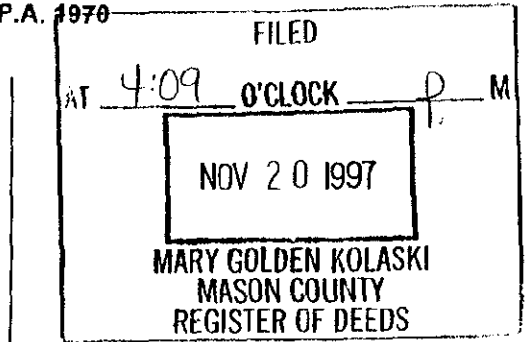

I, Richard L. Hays, in a field survey on August 1997, do hereby certify that under requirements of P.A. 74, Michigan P.A. of 1970, the corner points mentioned in lines 1 and 2 above were in conformance with regulations and rules therefore as required in the current manual of survey instructions of the United States Department of the Interior, Bureau of Land Management or by a decree of a Court of Law and/or that the corner points mentioned in lines 3, 4 and 5 above were in conformance with the rules of the Michigan Board of Land Surveyors or by a Decree of a Court of Law; established, re-established, monumented, re-monumented, recovered, found as expressed below:

NOTE: Not more than 4 corners, all in the same town and range, may be recorded on this certificate.

A. Description of original monument and accessories and/or subsequent restoration: H-1 NORTH QUARTER CORNER OF SECTION 3, T19N-R16W This corner was not established by G.L.O. Survey


1901: Survey No Witnesses

B. Description of corner evidence found and/or method applied in restoring or reestablishing corner: H-1 NORTH QUARTER CORNER OF SECTION 3, T19N-R16W August 1997: No evidence of Corner found. Corner was re-established by proportional measurement between closing Corners on line between the Standard Corners.

C. Description of monument for corner and accessories established to perpetuate locating the position of the corner: H-1 NORTH QUARTER CORNER OF SECTION 3, T19N-R16W August 1997: Set a Standard Mason County Monument This position was not established by Original Government Surveyor. This Monument is accepted as a careful and faithful reestablishment of the position of the Corner.

- Spike in West side 10" White Pine N-37°-E 35.10'
Spike in Southwest side 11" White Pine S-42°-E 43.99'
Spike in Northeast Side 4" Black Oak N-29°-W 40.38'
Set Re-Rod S-45°-W 17.56'
Standard Corner West 6.15'
Fence Post S-48°-W 36.46'
Northwest Corner West 2635.82'
Northeast Corner East 2635.82'

Grid table with columns A-M and rows 1-13. Contains numbers 1-36.

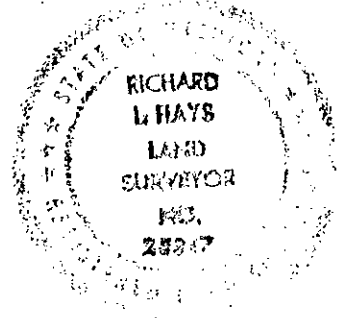

Signed by Richard Hays Date 11/6/97

Surveyor's Michigan License No. 25847

FORM APPROVED BY MICHIGAN STATE BOARD OF LAND SURVEYORS, JAN. 23, 1971