

SURVEY & REMONUMENTATION

OCT 29 1996

COMMISSION

LAND CORNER RECORDATION CERTIFICATE

Filing Requirement of Act 74, Mich. P.A. 1970

FILED

AT 9:46 O'CLOCK a M

AUG 20 1996

MARY GOLDEN KOLASKI
MASON COUNTY
REGISTER OF DEEDS

Register of Deeds Stamp & File Number

For corners in <u>Mason</u> (County)	Located in:	Corner Code #
1. Public Land Survey	T <u>19N</u> R <u>16W</u>	<u>H-05</u>
	T _____ R _____	_____
	T _____ R _____	_____
	T _____ R _____	_____
2. Property Controlling in Section	S _____ T _____ R _____	_____
	S _____ T _____ R _____	_____
3. Miscellaneous S Property in Sec.	T _____ R _____	_____
	S _____ T _____ R _____	_____
4. Lot No. _____	Recorded Plat _____	
5. Private Claims _____		

I, Kenneth L. Ross, in a field survey on August 6, 1996, do hereby certify that under requirements of P.A. 74, Michigan P.A. of 1970, the corner points mentioned in lines 1 and 2 above were in conformance with regulations and rules therefore as required in the current manual of survey instructions of the United States Department of the Interior, Bureau of Land Management or by a decree of a Court of Law and/or that the corner points mentioned in lines 3, 4 and 5 above were in conformance with the rules of the Michigan Board of Land Surveyors or by a Decree of a Court of Law; established, re-established, monumented, re-monumented, recovered, found as expressed below.

NOTE: Not more than 4 corners, all in the same town and range, may be recorded on this certificate.

	A	B	C	D	E	F	G	H	I	J	K	L	M
1													
2	6	5	4	3	2	1							
3													
4	7	8	9	10	11	12							
5				X									
6	18	17	16	15	14	13							
7													
8	19	20	21	22	23	24							
9													
10	30	29	28	27	26	25							
11													
12	31	32	33	34	35	36							
13													

A. Description of original monument and accessories and/or subsequent restoration:

- H-5 1/4 Cor., 10 & 15-19-16
1838 Sylvester Sibley
(1) 14" Elm N 53 E 7 lks
(2) 6" W. Ash S 52 W 10 lks

B. Description of corner evidence found and/or method applied in restoring or reestablishing corner:


- H-5 1/4 Cor., 10 & 15-19-16
Aug., 1903, R. O. Towns Fd. Iron Pipe (Book 2, Page 179-180, County Surveyor's Records)
Sep., 1903, R. O. Towns Fd. Iron Pipe (Book 4, Page 104-105, County Surveyor's Records)
Jun., 1975, K. Ross Set PK over Iron CL Asphalt Fence to North
(3) 24" Pin Oak S 20 W 33.07'
(4) 24" Pin Oak S 80 W 133.84'
May, 1976, K. Ross used corner in survey
Aug., 1996, K. Ross Fd. PK Nail & 2" Iron Pipe, CL Road

C. Description of monument for corner and accessories established to perpetuate locating the position of the corner:

- H-5 1/4 Cor., 10 & 15-19-16
Fd. Witness #3 (now 38" & nail grown over) & 4 (now 36" & nail grown over).
Witness #1 & 2 gone.
Replaced PK Nail & 2" Iron Pipe with 5/8" x 24" re-bar with 2 1/2" alum. cap in monument box, and is the best available evidence of the original corner.
(5) Power Pole S 83 W 211.37'
(6) West End Guard Rail S 78 E 208.12'
(7) West End Guard Rail N 88 E 207.51'

Signed by Kenneth L. Ross Date 8-12-96

Surveyor's Michigan License No. 17634

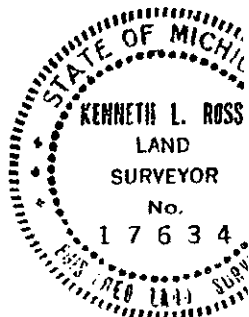

Peer Group Reviewed and Approved
Date: 8-13-96
Kenneth L. Ross
Mason County, MI