

FEB 08 2000


SECTION

LAND CORNER RECORDATION CERTIFICATE

Filing Requirement of Act 74, Mich. P.A. 1970

For corners In: Located In: Corner Code #
Mason County

- 1. Public Land Survey T 19N R 16W H-13
T _____ R _____
T _____ R _____
T _____ R _____
- 2. Property Controlling in Section S _____ T _____ R _____
S _____ T _____ R _____
- 3. Miscellaneous S _____ T _____ R _____
- Property in Sec. S _____ T _____ R _____

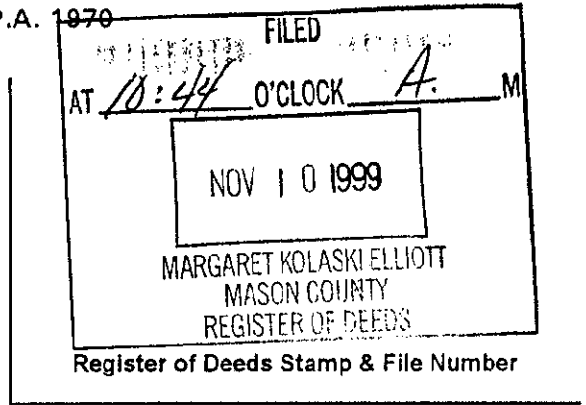

- 4. Lot No. _____, Recorded Plat _____
- 5. Private Claims _____

	A	B	C	D	E	F	G	H	I	J	K	L	M
1													
2	6	5	4	3	2	1							
3													
4	7	8	9	10	11	12							
5													
6	18	17	16	15	14	13							
7													
8	19	20	21	22	23	24							
9													
10	30	29	28	27	26	25							
11													
12	31	32	33	34	35	36							
13													

I, Kenneth L. Ross, in a field survey on September 4, 1999, Do hereby certify that under requirements of P.A. 74, Michigan P.A. of 1970, the corner points mentioned in lines 1 and 2 above were in conformance with regulations and rules therefore as required in the current manual of survey instructions of the United States Department of the Interior, Bureau of Land Management or by a decree of a Court of Law and/or that the corner points mentioned in lines 3, 4 and 5 above were in conformance with the rules of the Michigan Board of Land Surveyors or by a Decree of a Court of Law; established, re-established, monumented, re-monumented, recovered, found as expressed below:

NOTE: Not more than 4 corners, all in the same town and range, may be recorded on this certificate.

A. Description of original monument and accessories and/or subsequent restoration:

¼ Corner Section 34, T. 19N., R. 16W.,

GLO Mullett and Brookfield, 1838

Set quarter Section Post

(1) Hemlock, 6", N14°E, 27 links, (17.82')

(2) Beech, 7", N82°W, 22 links (14.52')

K.L. Ross, Act 132, 1998, Liber 487, page 1688

States" Set ½" I.B., 16.99' West of Corner

H-1, T. 18N., R. 16W.

(3) 13" Wild Cherry, N10°W, 43.47'

(4) 22" W. Pine, N08°E, 233.66'

(5) 9" Poplar, S48°E, 91.15'

(6) Closing Corner East, 16.99'

I found no other data on this corner.

B. Description of corner evidence found and/or method applied in restoring or reestablishing corner:

¼ Corner Section 34, T. 19N., R. 16W.,

I found the ½" I.B. as described above with Cap #17634. Witnesses (1), (2) and (5) have been destroyed. Witnesses (3), (4) and (6) are standing and in good condition. I found no other evidence to dispute the location of this corner.

C. Description of monument for corner and accessories established to perpetuate locating the position of the corner:

¼ Corner Section 34, T. 19N., R. 16W.,

I replaced the ½" I.B. in the exact location with a Standard 3" Cast Iron Harrison Monument stamped "Mason County Monument" in the Center-line and 1 foot below the surface of Decker Road. This corner accepted as the best available evidence of the re-establishment of the position of the original corner.

(3) 13" Wild Cherry, N10°W, 43.03'

(4) 22" W. Pine, N08°E, 233.68'

(6) H-1, T. 18N., R. 16W., Set Harrison cast iron monument, East, 16.99'

(7) Set 60d spike SE side Cedar Corner Fence Post, N70°E, 80.41'

(8) Set 60d Spike SW side Cedar Corner Fence Post, N3°W, 31.23'

LIBER 4 PAGE 310

Signed by [Signature] Date Nov 4, 1999

Surveyor's Michigan License No. 17634

Approved by Peer Review Group on Nov. 4, 1999
Kenneth L. Ross, County Representative [Signature]

