

SURVEY & REMONUMENTATION

MAR 16 1998


LAND CORNER RECORDATION CERTIFICATE

Filing Requirement of Act 74, Mich. P.A. 1970

For corners in SECTION
MASON (County)

Located In: Corner Code #

- 1. Public Land Survey T 19N R 16W I-2
- T R
- T R
- T R
- 2. Property Controlling S T R
- in Section S T R
- 3. Miscellaneous S T R
- Property in Sec. S T R

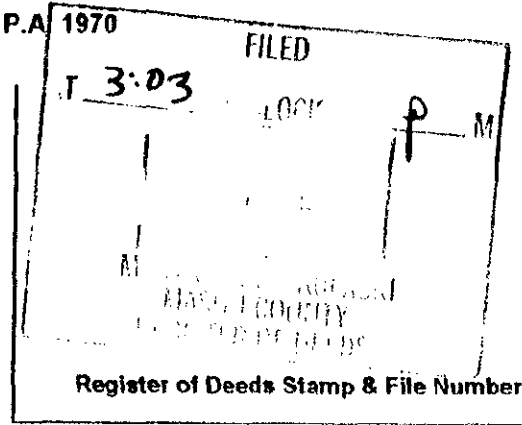

- 4. Lot No. _____, Recorded Plat _____
- 5. Private Claims _____

I, Kenneth L. Ross, in a field survey on October 24, 1997, do hereby certify that under requirements of P.A. 74, Michigan P.A. of 1970, the corner points mentioned in lines 1 and 2 above were in conformance with regulations and rules therefore as required in the current manual of survey instructions of the United States Department of the Interior, Bureau of Land Management or by a decree of a Court of Law and/or that the corner points mentioned in lines 3, 4 and 5 above were in conformance with the rules of the Michigan Board of Land Surveyors or by a Decree of a Court of Law; established, re-established, monumented, re monumented, recovered, found as expressed below:

	A	B	C	D	E	F	G	H	I	J	K	L	M
2	6	5	4	3	2	1							
3													
4	7	8	9	10	11	12							
5													
6	18	17	16	15	14	13							
7													
8	19	20	21	22	23	24							
9													
10	30	29	28	27	26	25							
11													
12	31	32	33	34	35	36							
13													

NOTE: Not more than 4 corners, all in the same town and range, may be recorded on this certificate.

A. Description of original monument and accessories and/or subsequent restoration:

I-2 1/4 corner for Sections 2 and 3, T19N-R16W.

1838, Sylvester Sibley, G.L.O.
Set Wood post

- #1 Beech 10" N 04° E 11 lks (7.26ft.)
- #2 Hemlock 8" S 13° W 14 lks. (9.24ft.)

1918, C. E. Mitchell, Mason County Survey
Established corner, and set a well point
no witnesses, Book 2, Page 224-225

1996, Kenneth Ross, RLS# 17634,

- Found 1 1/4" Well point, corner fits C.E. Mitchell's distances to I-3 and to I-1, less than a foot.
- #3 Power Pole S 62° E 36.50 ft.
- #4 Black Ash 13" N 14° W 94.48 ft.
- #5 Black Oak 13" N 20° E 104.40 ft.

B. Description of corner evidence found and/or method applied in restoring or reestablishing corner:

I-2 1/4 corner for Sections 2 and 3, T19N-R16W.

On October 24, 1997, I Ken Ross and Kevin Pritchard found a well point, placed by C. E. Mitchell. This corner was found in the center of Stephens Road(gravel). I found no evidence to dispute this location for the corner location.


Condition of recorded witnesses are: #1 Gone #2 Gone #3 Found in good condition #4 Found in good condition #5 Found in good condition

C. Description of monument for corner and accessories established to perpetuate locating the position of the corner:

I-2 1/4 corner for Sections 2 and 3, T19N-R16W.

I replaced, in the exact location, C. E. Mitchell's well point with a standard Mason County Monument(5/8" Re-Rod, 24" long, with a 2 1/2" aluminum cap, stamped to identify the corner. And is accepted as a careful and faithful re-establishment of the position of the original corner.

- Ext "BT" #3 Power Pole S 62° E 36.50 ft. (Ext. 60d spike in NE side of pole)
- Ext "BT" #4 Black Ash 13" N 14° W 94.48 ft. (Ext. 60d spike in NE side of tree)
- Ext "BT" #5 Black Oak 13" N 20° E 104.40 ft. (Ext. 60d spike in SE side of tree)
- Maple 6" S 15° W 93.30 ft. (Set 60d spike in SE side of tree)

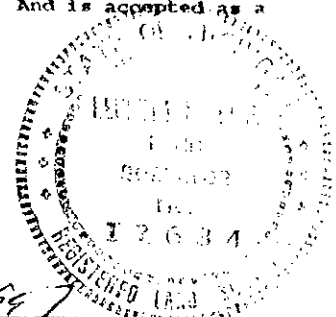

Signed by [Signature]
Surveyor's Michigan License No. 17643

Date Nov. 6, 1997

Peer Group I
and my
Date: Nov. 6, 1997
[Signature]
Kenneth L.
Mason County Sur.