

**SURVEY & REMONUMENTATION**

MAR 16 1998

**LAND CORNER RECORDATION CERTIFICATE**


Filing Requirement of Act 74, Mich. P.A. 1970

**SECTION**

For corners in MASON (County) Located in: \_\_\_\_\_ Corner Code # \_\_\_\_\_

1. Public Land Survey	T 19N R 16W	<u>I-03 I-03</u>
	T _____ R _____	_____
	T _____ R _____	_____
	T _____ R _____	_____
2. Property Controlling in Section	S _____ T _____ R _____	_____
	S _____ T _____ R _____	_____
3. Miscellaneous Property in Sec.	S _____ T _____ R _____	_____
	S _____ T _____ R _____	_____

4. Lot No. \_\_\_\_\_, Recorded Plat \_\_\_\_\_  
 5. Private Claims \_\_\_\_\_

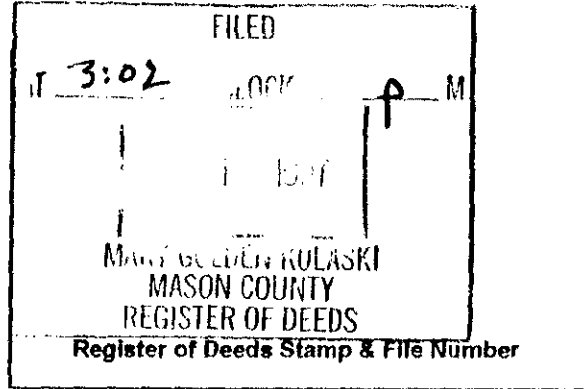

	A	B	C	D	E	F	G	H	I	J	K	L	M
1													
2	6	5	4	3	2	1							
3													
4	7	8	9	10	11	12							
5													
6	18	17	16	15	14	13							
7													
8	19	20	21	22	23	24							
9													
10	30	29	28	27	26	25							
11													
12	31	32	33	34	35	36							
13													

I, Kenneth L. Ross, in a field survey on October 24, 1997, do hereby certify that under requirements of P.A. 74, Michigan P.A. of 1970, the corner points mentioned in lines 1 and 2 above were in conformance with regulations and rules therefore as required in the current manual of survey instructions of the United States Department of the Interior, Bureau of Land Management or by a decree of a Court of Law and/or that the corner points mentioned in lines 3, 4 and 5 above were in conformance with the rules of the Michigan Board of Land Surveyors or by a Decree of a Court of Law, established, re-established, monumented, re-monumented, recovered, found as expressed below:

**NOTE: Not more than 4 corners, all in the same town and range, may be recorded on this certificate.**

**A. Description of original monument and accessories and/or subsequent restoration:**

I-3 Section Corner for Sections 3, 4, 10 and 11, T19N-R16W.

1838, Sylvester Sibley, G.L.O.  
12" Cedar for corner

1901, R.O. Towns, Mason County Surveyor  
Found stake by unknown Surveyor, placed Stone, Book 2, Page 21

1918, C.E. Mitchell, Mason County Survey  
Identify by stone & testimony, set Pipe Book 2, Page 225

1996, Kenneth Ross, RLS# 17634

Found 1 1/2" Iron pipe at the intersection of Beyer & Stephens Road, accepted as C.E. Mitchell Iron Pipe.

- #1 Tele-Phone Junc. Box N 25° W 55.33 ft.
- #2 Power Pole N 24° E 96.25 ft.
- #3 Maple Clump 4"-8" S 85° W 159.81 ft.
- #4 Ex. "BT" White Pine stump S 08° E 61.40 ft.

**B. Description of corner evidence found and/or method applied in restoring or reestablishing corner:**

I-3 Section Corner for Sections 3, 4, 10 and 11, T19N-R16W.

On October 24, 1997, I Ken Ross and Kevin Pritchard (survey tech.) found a 1 1/2" Iron pipe, 26" long, at the intersection of Beyer and Stephens Road, this is believed to be Mitchell Iron as of Book 2, Page 225. I found no evidence to dispute this location for the corner.

Condition of recorded witnesses are: #1 Found in good condition #2 Found in good condition #3 Found in good condition #4 Found in good condition

**C. Description of monument for corner and accessories established to perpetuate locating the position of the corner:**

I-3 Section Corner for Sections 3, 4, 10 and 11, T19N-R16W.


I replaced 1 1/2" Iron Pipe, in the exact location, with a standard Mason County Monument, (a 5/8" re-rod, 24" long, with a 2 1/2" aluminum cap, stamped to identify the corner) set 1.0 feet below Road surface (gravel). This corner is accepted as a careful and faithful, re-establishment of the position of the original corner.

- Ext "BP" #1 Tele-Phone Junc. Box N 25° W 55.33 ft. (top center)
- Ext "BP" #2 power Pole N 24° E 96.25 ft. (Ext. 60d spike in SE side of pole)
- Ext "BP" #3 Maple Clump 4"-8" S 85° W 159.81 ft. (Ext. 60d spike in NW side of tree)
- Ext "BT" #4 White Pine stump S 08° E 61.40 ft. (Ext. 60d spike in West side of tree)

Signed by [Signature]  
 Surveyor's Michigan License No. 17634

Date Nov 5, 1997

Peer Group Reviewed and Approved  
 Date: Nov 5, 1997  
[Signature]  
 Kenneth L. Ross  
 Mason County Surveyor

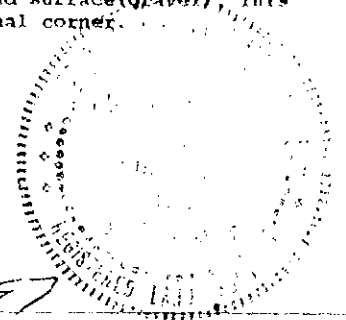

FILED [Signature]