


FEB 08 2000

SECTION

LAND CORNER RECORDATION CERTIFICATE

Filing Requirement of Act 74, Mich. P.A. 1976

For corners In: Located In: Corner Code #
 Mason County
 Public Land Survey T 19N R 16W I-13
 T R
 T R
 T R
 1. Property Controlling S T R
 in Section S T R
 3. Miscellaneous S T R
 Property in Sec. S T R

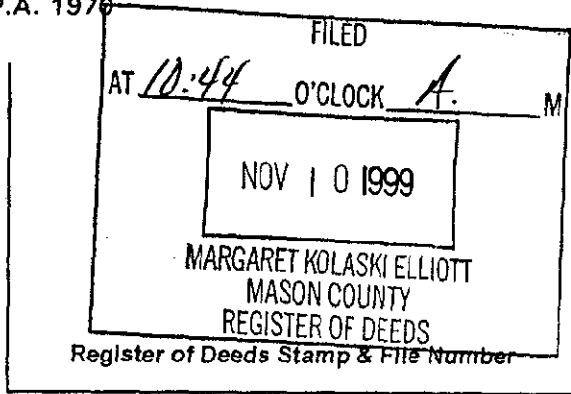

1. Lot No. _____, Recorded Plat _____
 3. Private Claims _____

Kenneth L. Ross, in a field survey on August 28, 1999, Do hereby certify that under requirements of P.A. 74, Michigan P.A. of 1970, the corner points mentioned in lines 1 and 2 above were in conformance with regulations and rules therefore as required in the current manual of survey instructions of the United States Department of the Interior, Bureau of Land Management or by a decree of a Court of Law and/or that the corner points mentioned in lines 3, 4 and 5 above were in conformance with the rules of the Michigan Board of Land Surveyors or by a Decree of a Court of Law; established, re-established, monumented, re-monumented, recovered, found as expressed below:

	A	B	C	D	E	F	G	H	I	J	K	L	M
2	6	5	4	3	2	1							
3													
4	7	8	9	10	11	12							
5													
6	18	17	16	15	14	13							
7													
8	19	20	21	22	23	24							
9													
10	30	29	28	27	26	25							
11													
12	31	32	33	34	35	36							
13													

NOTE: Not more than 4 corners, all in the same town and range, may be recorded on this certificate.

A. Description of original monument and accessories and/or subsequent restoration:

Corner Common To Sections 34 and 35 T.19N., R.16W.,

GLO Mullet and Brookfield
 1838, Set Post Corner Secs. 34 and 35
 (1) Tamarack, S88°W, 30 links (19.80')
 (2) unreadable, N84°E, 44.5 links (29.37')

K.L. Ross, 1984, States "No Corner Set. Distance East to I-1, T.18N., R.16W., 14.52' Distance North to I-12, 2675.02'

K.L. Ross, Act 132, Liber 487, page 1688
 "Existing P.K. Nail over Iron, 14.52' West I-1, T.18N., R.16W.,
 (3) P.P. N45°E, 63.78'
 (4) Top wood post, S82°E, 43.85'
 (5) Top wood post, N22°W, 20.97'
 (6) I-1, T.18N., R.16W., East, 14.52'

W.E. Metcalf, 1890, Survey of Section 35,
 Does not state what he found or set. No Witnesses Given:
 Distance North to I-12, 2681.58'
 Distance East to J-13, 2640.00'

K.L. Ross, 1995, Does not state what he found. No Witnesses Given.
 Distance North to I-12, 2675.02'

B. Description of corner evidence found and/or method applied in restoring or reestablishing corner:

Corner Common To Sections 34 and 35 T.19N., R.16W.,

Found P.K. nail over 3/4" X 24" pipe, 3' South of the Center-line of Decker Road and 30' East of the center of a Bridge to the West and 17.5' West of the center-line of Stephens Road. I could find no other evidence to dispute the location of this corner. There is evidence of other witnesses in the area, but, I could not find any other information regarding these witnesses. Witness (6) is standing and in good condition, Witnesses (1) thru (5) have been destroyed except for possibly (5) of which I am not sure if it is or has been replaced.

C. Description of monument for corner and accessories established to perpetuate locating the position of the corner:

Corner Common To Sections 34 and 35 T.19N., R.16W.,


I replaced the 3/4" X 24" iron pipe in the exact location with a Standard 3" Cast Iron Harrison Monument stamped "Mason County Monument" 1 foot below the surface of Decker Road, 3' South of the center-line and 30' East of the center of a bridge to the West. This corner accepted as the best available evidence of the re-establishment of the position of the original corner.

- (6) I-1, T.18N., R.16W., Set 3" Harrison cast iron monument, East, 14.52'
- (7) Existing 60d spike, Top Guard Rail Post, N18°W, 20.31' (Could be witness (5) above)
- (8) Set 60d spike SE side of P.P. N60°E, 63.78'
- (9) Set 60d spike Top Guard Rail Post, S18°W, 9.60'
- (10) Existing 60d spike Top Guard Rail Post, S09°E, 38.41'
- (11) Set 60d spike Top Guard Rail Post, S37°E, 48.15'

Signed by Kenneth L. Ross Date Nov 4, 1999

Surveyor's Michigan License No. 17634

Approved by Peer Review Group on Nov 4, 1999
 Kenneth L. Ross, County Representative [Signature]

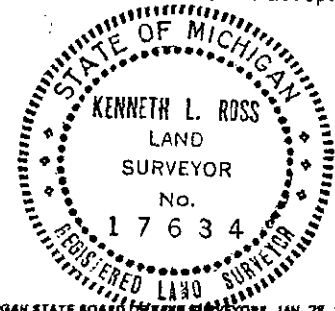

FORM APPROVED BY MICHIGAN STATE BOARD OF LAND SURVEYORS, JAN. 28, 1971
 REVISED MAY 14, 1975
 REVISED JAN. 1983
 ADAPTED FOR WORD PROCESSING MARCH, 1993