

SURVEY & REMONUMENTATION

MAR 16 1998

LAND CORNER RECORDATION CERTIFICATE

Filing Requirement of Act 74, Mich. P.A. 1970


For corner SECTION
MASON
 (County)

Located In: _____ Corner Code # _____

1. Public Land Survey T 19N R 16W J-1
 T _____ R _____
 T _____ R _____
 T _____ R _____

2. Property Controlling in Section S _____ T _____ R _____
 S _____ T _____ R _____

3. Miscellaneous Property in Sec. S _____ T _____ R _____
 S _____ T _____ R _____

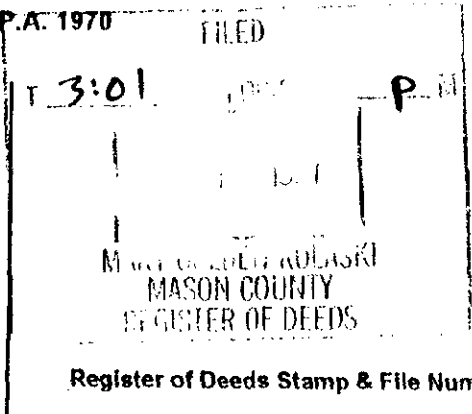

4. Lot No. _____, Recorded Plat _____
 5. Private Claims _____

	A	B	C	D	E	F	G	H	I	J	K	L	M
1													
2	6	5	4	3	2	1							
3													
4	7	8	9	10	11	12							
5													
6	18	17	16	15	14	13							
7													
8	19	20	21	22	23	24							
9													
10	30	29	28	27	26	25							
11													
12	31	32	33	34	35	36							
13													

I, Kenneth L. Ross, in a field survey on October 24, 1997, do hereby certify that under requirements of P.A. 74, Michigan P.A. of 1970, the corner points mentioned in lines 1 and 2 above were in conformance with regulations and rules therefore as required in the current manual of survey instructions of the United States Department of the Interior, Bureau of Land Management or by a decree of a Court of Law and/or that the corner points mentioned in lines 3, 4 and 5 above were in conformance with the rules of the Michigan Board of Land Surveyors or by a Decree of a Court of Law; established, re-established, monumented, re-monumented, recovered, found as expressed below:

NOTE: Not more than 4 corners, all in the same town and range, may be recorded on this certificate.

A. Description of original monument and accessories and/or subsequent restoration:

I-1 North 1/4 Corner for Section 2, T19N-R16W.

Note: G.L.O. did not set this corner.

1918, C. E. Mitchell, Mason County Surveyor
 Identify corner, by found stake, Set Well Point
 Book 2 Page 224-225


1996, Kenneth Ross, RLS# 17634
 Found Well Point in Cadastral Survey of
 Section 2, accepted as C. E. Mitchell Corner.
 #1 Red Oak 22" N 46° E 89.18 ft.
 #2 Beech Twin 7" N 32° W 35.87 ft.
 #3 Maple 9" S 50° W 13.09 ft.
 #4 Iron Pipe 1" N 27° W 13.78 ft.

B. Description of corner evidence found and/or method applied in restoring or reestablishing corner:

I-1 North 1/4 Corner for Section 2, T19N-R16W.

On October 24, 1997, I Ken Ross and Kevin Pritchard (survey tech.), found 1 1/4 Well Point, set by C. E. Mitchell as of L. 2, P. 224 & 225, we also found a 1" iron pipe, 36" above the ground with existing witnesses, we did not except this 1" iron pipe for the corner, we found no other evidence to dispute the location of the well point.

Condition of recorded witness are: #1 Found in good condition #2 Found in good condition #3 Found in good condition #4 Found in good condition

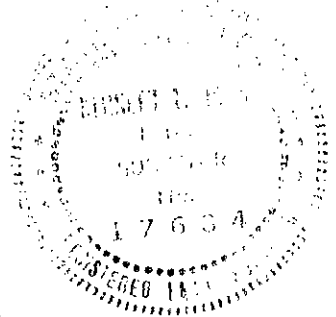

C. Description of monument for corner and accessories established to perpetuate locating the position of the corner:

I-1 North 1/4 Corner for Section 2, T19N-R16W.

I replaced 1 1/4" Well Point, in the exact location, with a Standard Mason County Monument, (5/8" re-rod, 24" long, with a 2 1/2" aluminum cap. This corner is accepted as a careful and faithful perpetuation of the position of the original corner.

Ext. "BT" #1 Red Oak 22" N 46° E 89.18 ft. (Ext. 60d spike in SE side of tree)
 Ext. "BT" #2 Beech Tw. 7" N 32° W 35.87 ft. (Ext. 60d spike in NE side of tree)
 Ext. "BT" #3 Maple 9" S 50° W 13.09 ft. (Ext. 60d spike in SE side of tree)
 Ext witness #4 Iron Pipe 1" N 27° W 13.78 ft.
 Standard corner for the South 1/4 corner for Section 35, T20N-R16W West 6.57 feet

Signed by [Signature] Date Nov 5, 1997
 Surveyor's Michigan License No. 17634

[Signature]
 Date Nov 5, 1997
 Mason County