

FEB 08 2000


SECTION

LAND CORNER RECORDATION CERTIFICATE

Filing Requirement of Act 74, Mich. P.A. 1970

For corners In: Located In: Corner Code #
Mason County

- 1. Public Land Survey T 19N R 16W J-13
T R
T R
T R
- 2. Property Controlling in Section S T R
S T R
- 3. Miscellaneous S T R
- Property in Sec. S T R

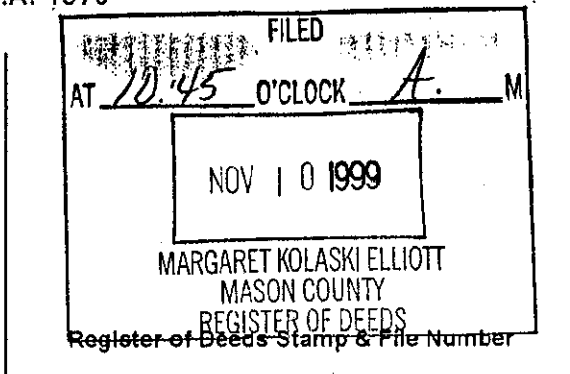

- 4. Lot No. _____, Recorded Plat _____
- 5. Private Claims _____

	A	B	C	D	E	F	G	H	I	J	K	L	M
1													
2	6	5	4	3	2	1							
3													
4	7	8	9	10	11	12							
5													
6	18	17	16	15	14	13							
7													
8	19	20	21	22	23	24							
9													
10	30	29	28	27	26	25							
11													
12	31	32	33	34	35	36							
13													

I, Kenneth L. Ross, in a field survey on September 4, 1999, Do hereby certify that under requirements of P.A. 74, Michigan P.A. of 1970, the corner points mentioned in lines 1 and 2 above were in conformance with regulations and rules therefore as required in the current manual of survey instructions of the United States Department of the Interior, Bureau of Land Management or by a decree of a Court of Law and/or that the corner points mentioned in lines 3, 4 and 5 above were in conformance with the rules of the Michigan Board of Land Surveyors or by a Decree of a Court of Law; established, re-established, monumented, re-monumented, recovered, found as expressed below:

NOTE: Not more than 4 corners, all in the same town and range, may be recorded on this certificate.

A. Description of original monument and accessories and/or subsequent restoration:

South 1/4 Corner Section 35, T.19N., R.16W.,

GLO, Mullett and Brookfield, 1838
"Set quarter section post"

- (1) Beech, 16", N54°E, 31 links (19.80')
- (2) unreadable, 6", N12°W, 21 links (13.86')

W.E. Metcalf, 1890, Book 1, page 233,
States "Found Old Stake and Stumps of
Government Witnesses"

- (3) Sugar, 11", N23°W, 13 links (8.58')
- (4) Beech, 7", N25°E, 26 links (17.16')
- Distance West to I-13, 2640.00'
- Distance East to K-13, 2631.42'
- Distance North to J-11, 5269.44'

Robert L. Wetherell, Act 132, Liber 447, page 593
and LCRC, Liber 3, page 276, 1995, States

- "Found 1/2" capped iron (Bonney), 6' South of Center-line
of East-West Gravel Road"
- (5) 10" Cherry, N5°E, 277.85'
- (6) P. Pole, S70°E, 101.00'
- (7) 8" Jack Pine, S15°W, 23.36'
- (8) 10" Jack Pine, S67°W, 36.60'
- (9) 1/2" Re-bar, N 1/4 Cor Sec. 3, T.18N., R.16W., East, 11.96'

B. Description of corner evidence found and/or method applied in restoring or reestablishing corner:

South 1/4 Corner Section 35, T.19N., R.16W.,

I found the 1/2" capped iron (Bonney) as described by Robert L. Wetherell above. Witnesses (1) through (4) have been destroyed. Witnesses (5) through (9) are standing and in good condition. I found no other evidence to dispute the location of this corner.

C. Description of monument for corner and accessories established to perpetuate locating the position of the corner:

South 1/4 Corner Section 35, T.19N., R.16W.,

I replaced the 1/2" capped re-rod in the exact location with a Standard 3" Cast Iron Harrison Monument stamped "Mason County Monument" 6 foot South of the Center-line of Decker Road and 1 foot below the surface. This corner accepted as the best available evidence of the re-establishment of the position of the original corner. It is very apparent that this corner has also been used for J-1, T.18N., R.16W., as there are fence lines that run North and South from this Corner.

- (5) 10" Cherry, Existing 60d spike East side, N5°E, 277.80'
- (6) P. Pole, Existing 60d spike, North Side, S70°E, 101.00'
- (7) 8" Jack Pine, Existing 60d spike, West side, S15°W, 23.36'
- (8) 10" Jack Pine, Existing 60d spike, North side, S67°W, 36.60'
- (9) J-1, T.18N., R.16W., Set 3" Harrison Cast Iron Monument., East, 11.96'
- (10) Set 60d spike West Side Treated 8" X 8" Post, N2°E, 33.53'
- (11) Set 60d Spike N side P.P. S88°W, 180.07'

Signed by [Signature] Date Nov. 4, 1999

Surveyor's Michigan License No. 17634

Approved by Peer Review Group on Nov. 4, 1999
Kenneth L. Ross, County Representative [Signature]

