

SURVEY & MONUMENTATION
REMONUMENTATION

MAR 16 1998

LAND CORNER RECORDATION CERTIFICATE

Filing Requirement of Act 74, Mich. P.A./1970

For corners in SECTION
 MASON (County)

Located In: Corner Code #

- 1. Public Land Survey T 19N R 16W Kx3
- 2. Property Controlling in Section S T R
- 3. Miscellaneous Property in Sec. S T R

FILED
 2:54 P.M.
 REGISTER OF DEEDS
 Register of Deeds Stamp & File Number

4 Lot No. _____, Recorded Plat _____
 5 Private Claims _____

I, Kenneth L. Ross, in a field survey on October, 24 19 97, do hereby certify that under requirements of P.A. 74, Michigan P.A. of 1970, the corner points mentioned in lines 1 and 2 above were in conformance with regulations and rules therefore as required in the current manual of survey instructions of the United States Department of the Interior, Bureau of Land Management or by a decree of a Court of Law and/or that the corner points mentioned in lines 3, 4 and 5 above were in conformance with the rules of the Michigan Board of Land Surveyors or by a Decree of a Court of Law; established, re-established, monumented, re-monumented, recovered, found as expressed below:

	A	B	C	D	E	F	G	H	I	J	K	L	M
1													
2	6	5	4	3	2	1							
3													
4	7	8	9	10	11	12							
5													
6	18	17	16	15	14	13							
7													
8	19	20	21	22	23	24							
9													
10	30	29	28	27	26	25							
11													
12	31	32	33	34	35	36							
13													

NOTE: Not more than 4 corners, all in the same town and range, may be recorded on this certificate.

A Description of original monument and accessories and/or subsequent restoration:
 K-3 Section Corner for Sections 1, 2, 11 and 12, T19N-R16W.

1838, Sylvester Sibley, G.L.O.
 Set Wood Post

- #1 Beech 10" S 17° W 5 lks. (3.30 ft.)
- #2 Beech 8" N 25° E 3 lks. (1.98 ft.)

1903, R.O. Towns, Mason County Survey
 Identify by Stone & witness stump of bearing tree. Book 4, Page 106

1918, C.E. Mitchell, Mason County Surveyor
 Identify by Stone and testimony
 Book 2 page 224, 225

1970, J. Horsfay, M.C.R.C.

- Found 3/4" Iron Bolt, found two existing witnesses Nail & Tag SW in Power Pole, Nail & Tag NE Dead Elm clump, 3/4" Bolt lost in Road Construction Reset from witnesses a 1" by 18" Iron Rod.
- #3 Power Pole SW 50.02 ft. (Tag & Nail)
- #4 Tele. Pole SE 72.08 ft. (Tag & Nail)
- #5 Elm Clump (dead) NE 65.94 ft. (Tag & Nail)

1996, Kenneth Ross, RLS# 17634,
 Found 1" Iron in existing monument box, in Cadastral survey of Sec. 2, T19N-R16W.

B. Description of corner evidence found and/or method applied in restoring or reestablishing corner:
 K-3 Section Corner for Sections 1, 2, 11 and 12, T19N-R16W.

On October 24, 1997, I found a 1" Iron Pipe, 18" long inside an existing monument box, on the North side of Beyer Road (paved), I found no other evidence was found to disputed this location for the corner.


Condition of recorded witnesses are: #1 Gone #2 Gone #3 Found in good condition #4 Gone

#5 Gone

C. Description of monument for corner and accessories established to perpetuate locating the position of the corner:
 K-3 Section Corner for Sections 1, 2, 11 and 12, T19N-R16W.

I replaced 1" Iron Pipe, with a standard Mason County Monument (5/8" re-rod, 18" in length, w/ a 2 1/2" aluminum cap, stamped to identify the corner. Re-rod was set inside the existing monument box, in the exact location of 1" iron pipe, and is accepted as a careful and faithful re-establishment of the position of the original corner.

- Ext. "BP" #3 Power Pole S 30° W 50.02 ft. (16p w/ shiner in NW side of pole).
- Apple 14" N 68° W 88.80 ft. (60d spike in SW side of tree)
- Power Pole S 78° E 154.56 ft. (60d spike in SW side of tree)
- Tele- Junc. Box S 32° E 73.72 ft. (top center)

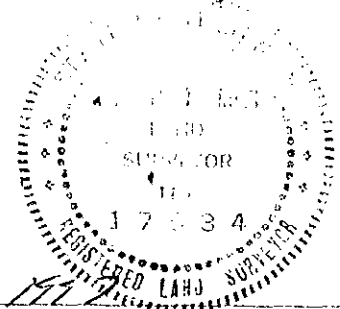

Signed by [Signature]
 Surveyor's Michigan License No. 17634

Date Nov. 5, 1997

Date: Nov 5 1997
 Kenneth Ross
 Mason County Surveyor