SURVEY &
REMONUMENTATION

APR 28 1995

COMMISSION

LAND CORNER RECORDATION CERTIFICATE
Filing Requirement of Act 74, Mich. P.A. 1970

FILED
AT 2:35 O'CLOCK P M
NOV 22 1994
MARY GOLDEN KOLASKI
MASON COUNTY
REGISTER OF DEEDS

Register of Deeds Stamp & File Number

For corners in

MASON (County)

		Located In:	Corner Code #
1. Public Land Survey		T 19N R 16W	K-5
		T ___ R ___	
		T ___ R ___	
		T ___ R ___	Seg. 1
2. Property Controlling	S ___	T ___ R ___	
in Section	S ___	T ___ R ___	
3. Miscellaneous	S ___	T ___ R ___	
Property in Sec.	S ___	T ___ R ___	

4. Lot No. _____ , Recorded Plat _____
5. Private Claims _____

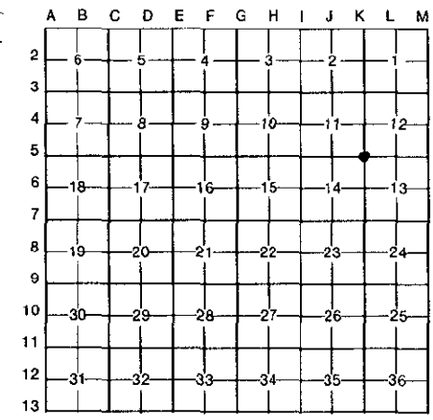

I, Theodore H. Weinert, in a field survey on JULY, 19 94, do hereby certify that under requirements of P.A. 74, Michigan P.A. of 1970, the corner points mentioned in lines 1 and 2 above were in conformance with regulations and rules therefore as required in the current manual of survey instructions of the United States Department of the Interior, Bureau of Land Management or by a decree of a Court of Law and/or that the corner points mentioned in lines 3, 4 and 5 above were in conformance with the rules of the Michigan Board of Land Surveyors or by a Decree of a Court of Law; established, re-established, monumented, re-monumented, recovered, found as expressed below:

NOTE: Not more than 4 corners, all in the same town and range, may be recorded on this certificate.

A. Description of original monument and accessories and/or subsequent restoration:

K-5 Section Corner, Secs. 11, 12, 13 & 14
G.L.O. Notes Set Post
July 7, 1838, Sylvester Sibley
16" Beech S 65 E 11 lks
10" Hemlock N 34 W 14 lks
May, 1902, R. O. Towns Fd iron rod (Book 2, Page 31)
May, 1903, R. O. Towns Fd iron

Undated record from Sam Barnett, PLS, Fd 2" iron Pit witnesses described
July 25, 1977, & May 19, 1992, Ken Ross, PLS, Fd existing bolt with large head no witness given

B. Description of corner evidence found and/or method applied in restoring or reestablishing corner:

K-5 Section Corner, Secs. 11, 12, 13 & 14
Found 2" iron with large forged head, appears to be a tool used during lumbering years.
Attempted to replace corner with no success
This corner location is accepted as a careful and faithful perpetuation of the original corner.

C. Description of monument for corner and accessories established to perpetuate locating the position of the corner:

K-5 Section Corner, Secs. 11, 12, 13 & 14
Left corner found in place, 2" iron bar with 3" forged head.
Spike in Power Pole S 64 E 32.71'
Spike in North Guard Rail Post N 48 E 16.65'
Street Name Sign CL Steel Post N 25 E 14.68'
Clump of Basswood, Spike in 6" tree furthest south S 80 W 16.00'
12" Cherry S 10 E 6.10'

STATE OF MICHIGAN
THEODORE H. WEINERT
LAND SURVEYOR
No. 19846
REGISTERED LAND SURVEYOR

Signed by Theodore H. Weinert Date 11/6/94

Surveyor's Michigan License No. 19846

Peer Group Reviewed and Approved
Date: 11-7-94
Kenneth L. Ross
Mason County

FORM APPROVED BY MICHIGAN STATE BOARD OF LAND SURVEYORS, JAN. 28, 1971
REVISED MAY 14, 1975
REVISED JAN., 1983

LIBER 3 PAGE 229