

**SURVEY &
REMONUMENTATION**

APR 28 1995

COMMISSION

LAND CORNER RECORDATION CERTIFICATE
Filing Requirement of Act 74, Mich. P.A. 1970


For corners in

MASON
(County)

Located In:

Corner Code #

- | | | | |
|---------------------------------------|---|-------------------------|---------------|
| 1. Public Land Survey | T | <u>19N</u> R <u>16W</u> | K-6 |
| | T | _____ R _____ | _____ |
| | T | _____ R _____ | _____ |
| | T | _____ R _____ | _____ |
| 2. Property Controlling in Section | S | T _____ R _____ | <u>Sec. 1</u> |
| | S | _____ T _____ R _____ | _____ |
| 3. Miscellaneous Property in Sec. | S | _____ T _____ R _____ | _____ |
| | S | _____ T _____ R _____ | _____ |
| 4. Lot No. _____, Recorded Plat _____ | | | |
| 5. Private Claims _____ | | | |

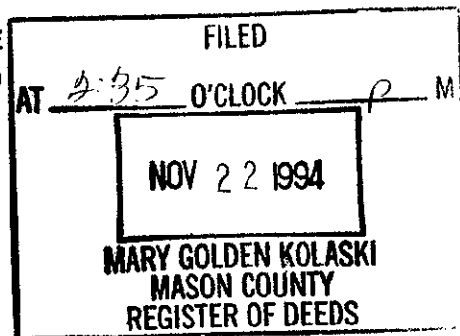

Register of Deeds Stamp & File Number

I, Theodore H. Weinert, in a field survey on JULY, 1994, do hereby certify that under requirements of P.A. 74, Michigan P.A. of 1970, the corner points mentioned in lines 1 and 2 above were in conformance with regulations and rules therefore as required in the current manual of survey instructions of the United States Department of the Interior, Bureau of Land Management or by a decree of a Court of Law and/or that the corner points mentioned in lines 3, 4 and 5 above were in conformance with the rules of the Michigan Board of Land Surveyors or by a Decree of a Court of Law; established, re-established, monumented, re-monumented, recovered, found as expressed below.

NOTE: Not more than 4 corners, all in the same town and range, may be recorded on this certificate.

A	B	C	D	E	F	G	H	I	J	K	L	M
2	6	5	4	3	2	1						
3												
4	7	8	9	10	11	12						
6												
6	18	17	16	15	14	13						
7												
8	19	20	21	22	23	24						
9												
10	30	29	28	27	26	25						
11												
12	31	32	33	34	35	36						
13												

A. Description of original monument and accessories and/or subsequent restoration:


- K-6 1/4 Corner, Secs. 13 & 14
 G.L.O. Notes Set Quarter Section Post August 17, 1961, Kenneth Stephens, RLS, Fd existing iron
 July 7, 1838, Sylvester Sibley Undated record from Sam Barnett, PLS, Fd
 16" Maple N 88 E 13 lks 1/2" X 18" pipe and set 1 1/4" riser
 12" Hemlock S 85 W 5 lks July 7, 1977, Ken Ross, PLS, Fd existing iron in monument box
 August 27-29, 1888, J. A. Mitchell planted stake for corner (Book 1, Page 199)
 May, 1902, R. O. Towns located stake and planted a stone with X (Book 2, Page 31)

B. Description of corner evidence found and/or method applied in restoring or reestablishing corner:

- K-6 1/4 Corner, Secs. 13 & 14
 Found 1 1/4" pipe in monument box
 No witnesses remained from previous surveys of record.
 Fit pipe as described by Sam Barnett, PLS.
 This corner location is accepted as a careful and faithful perpetuation of the original corner.

C. Description of monument for corner and accessories established to perpetuate locating the position of the corner:

- K-6 1/4 Corner, Secs. 13 & 14
 Set 5/8" X 24" rebar inside 1 1/4" pipe in monument box with standard 2 1/2" cap stamped "Mason County Remonumentation", on CL Reek Road North and South & CL Manales Road to the West Overhead Light Pole N 40 W 38.70'
 Spike in Power Pole with Transformer S 62 W 64.68'
 West Leg of Village Limit Sign S 22 E 45.75'
 CL 2" Maple N 65 E 47.88'
 CL 18" White Pine N 29 E 66.06'

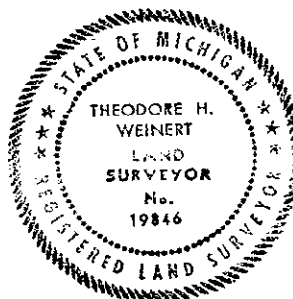

Signed by Theodore H. Weinert

Date 11/14/94

Surveyor's Michigan License No. 19846 Peer Group Reviewed and Approved

Date: 11-7-94
Kenneth L. Ross
 Mason County Surveyor