

MAR 16 1998

SECTION

LAND CORNER RECORDATION CERTIFICATE
Filing Requirement of Act 74, Mich. P.A. 1970

For corners in

MASON (County) Located In: Corner Code #


1. Public Land Survey T 19N R 16W K-6
 T _____ R _____
 T _____ R _____
 T _____ R _____

2. Property Controlling S _____ T _____ R _____
 In Section S _____ T _____ R _____

3. Miscellaneous S _____ T _____ R _____
 Property in Sec. S _____ T _____ R _____

4. Lot No. _____, Recorded Plat _____

5. Private Claims _____

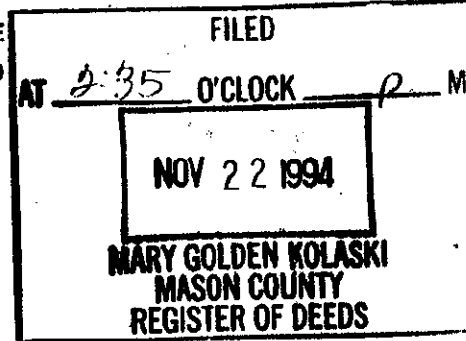

Register of Deeds Stamp & File Number

1. Theodore H. Weinert in a field survey on JULY, 19 94, do hereby certify that under requirements of P.A. 74, Michigan P.A. of 1970, the corner points mentioned in lines 1 and 2 above were in conformance with regulations and rules therefore as required in the current manual of survey instructions of the United States Department of the Interior, Bureau of Land Management or by a decree of a Court of Law and/or that the corner points mentioned in lines 3, 4 and 5 above were in conformance with the rules of the Michigan Board of Land Surveyors or by a Decree of a Court of Law; established, re-established, monumented, re-monumented, recovered, found as expressed below:

A	B	C	D	E	F	G	H	I	J	K	L	M
2	6	5	4	3	2	1						
3												
4	7	8	9	10	11	12						
5												
6	18	17	16	15	14	13						
7												
8	19	20	21	22	23	24						
9												
10	30	29	28	27	26	25						
11												
12	31	32	33	34	35	36						
13												

NOTE: Not more than 4 corners, all in the same town and range, may be recorded on this certificate.

A. Description of original monument and accessories and/or subsequent restoration:

K-6 1/4 Corner, Secs. 13 & 14

G.L.O. Notes Set Quarter Section Post July 7, 1838, Sylvester Sibley 16" Maple N 88 E 13 lks 12" Hemlock S 85 W 5 lks August 27-29, 1888, J. A. Mitchell planted stake for corner (Book 1, Page 199) May, 1902, R. O. Towns located stake and planted a stone with X (Book 2, Page 31)	August 17, 1961, Kenneth Stephens, RLS, Pd existing iron Undated record from Sam Barnett, PLS, Pd 1/2" X 18" pipe and set 1 1/4" riser July 7, 1977, Ken Ross, PLS, Pd existing iron in monument box
---	---

B. Description of corner evidence found and/or method applied in restoring or reestablishing corner:

K-6 1/4 Corner, Secs. 13 & 14

Found 1 1/4" pipe in monument box

No witnesses remained from previous surveys of record.

Fit pipe as described by Sam Barnett, PLS.

This corner location is accepted as a careful and faithful perpetuation of the original corner.

C. Description of monument for corner and accessories established to perpetuate locating the position of the corner:

K-6 1/4 Corner, Secs. 13 & 14

Set 5/8" X 24" rebar inside 1 1/4" pipe in monument box with standard 2 1/2" cap stamped "Mason County Remonumentation", on CL Reek Road North and South & CL Manales Road to the West Overhead Light Pole N 40 W 38.70'

Spike in Power Pole with Transformer S 62 W 64.68'

West Leg of Village Limit Sign S 22 E 45.75'

CL 2" Maple N 65 E 47.88'

CL 18" White Pine N 29 E 66.06'



Peer Group Reviewed and Approved
Date: 11/14/94
Kenneth L. Ross
Mason County Surveyor

Signed by Theodore H. Weinert

Date 11/14/94

Surveyor's Michigan License No. 19846

Peer Group Reviewed and Approved
Date: 11-7-94
Kenneth L. Ross
Mason County Surveyor