

FEB 08 2000

**SECTION**


**LAND CORNER RECORDATION CERTIFICATE**

Filing Requirement of Act 74, Mich. P.A. 1970

For corners In: Located In: Corner Code #

Mason County

- 1. Public Land Survey T 19N R 16W L-13
- T R
- T R
- T R
- 2. Property Controlling S T R
- in Section S T R
- 3. Miscellaneous S T R
- Property in Sec. S T R

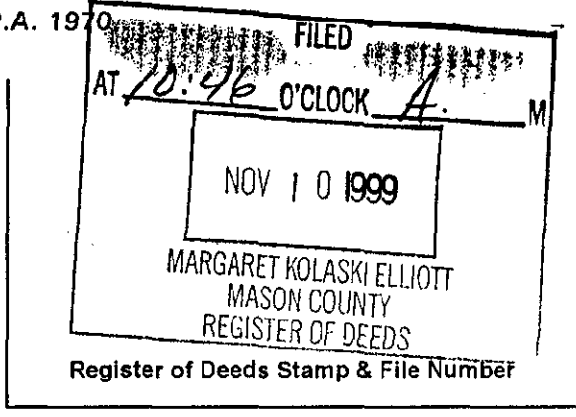

- 4. Lot No. \_\_\_\_\_, Recorded Plat \_\_\_\_\_
- 5. Private Claims \_\_\_\_\_

	A	B	C	D	E	F	G	H	I	J	K	L	M
1													
2	6	5	4	3	2	1							
3													
4	7	8	9	10	11	12							
5													
6	18	17	16	15	14	13							
7													
8	19	20	21	22	23	24							
9													
10	30	29	28	27	26	25							
11													
12	31	32	33	34	35	36							
13													

I, Kenneth L. Ross, in a field survey on October 16, 1999, Do hereby certify that under requirements of P.A. 74, Michigan P.A. of 1970, the corner points mentioned in lines 1 and 2 above were in conformance with regulations and rules therefore as required in the current manual of survey instructions of the United States Department of the Interior, Bureau of Land Management or by a decree of a Court of Law and/or that the corner points mentioned in lines 3, 4 and 5 above were in conformance with the rules of the Michigan Board of Land Surveyors or by a Decree of a Court of Law; established, re-established, monumented, re-monumented, recovered, found as expressed below:

NOTE: Not more than 4 corners, all in the same town and range, may be recorded on this certificate.

**A. Description of original monument and accessories and/or subsequent restoration:**

S ¼ Corner Section 36, T.19N., R.16W.,

GLO, Mullett and Brookfield, 1838  
 "Set quarter section post"

- (1) Tamarack, 7", N33°W, 25 links (16.50')
- (2) Tamarack, 8", N57°E, 18 links (11.88')

W.E. Metcalf, Book 1, page 258, 1892  
 Recorded by J.A. Mitchell

"Identified by old stumps, set new stake stumps to much decayed to use for witnesses."  
 No new witnesses given.  
 Distance West to K-13, 2637.36'  
 Distance East to M-13, 2631.42'  
 Distance North to L-11, 5298.48'

I found no other recorded documentation on this corner.

**B. Description of corner evidence found and/or method applied in restoring or reestablishing corner:**

S ¼ Corner Section 36, T.19N., R.16W.,

I could not locate this corner in the field. Witnesses (1) and (2) have been destroyed. I measured the distance from Corner K-13, to M-13, (5266.13'). I then prorated Metcalf Distance of (5268.78') in relation to his recorded distance from M-13 to this location.

$$\frac{5266.13}{5268.78} \times 2631.42 = 2630.10'$$


I then placed the location of this corner at a distance of 2630.10' from Corner M-13, on a straight line between Corner M-13 and Corner K-13.

**C. Description of monument for corner and accessories established to perpetuate locating the position of the corner:**

S ¼ Corner Section 36, T.19N., R.16W.,

I set a 3" Harrison Cast Iron Monument, "Stamped Mason County Monument" at this location as described in (B) above and accepted this location as a careful and faithful reestablishment of the position of the original corner.

- (3) Corner L-1, T.18N., R.16W., Set 3" Harrison cast iron monument, East, 1.64'
- (4) Set 60d spike top Cedar Fence Post, N29° E, 17.98'
- (5) Set 60d spike top Cedar Fence Post, N59° E, 29.40'
- (6) Most Westerly Corner of Permanent Hunters Blind, N16°W, 40.27'
- (6) N. End of 18' CMP, N13°W, 10.42'
- (7) S. End of 18' CMP, S07°W, 30.07'
- Fence Corner to North and East, North 18'
- Center Line of Two Track (Decker Road), South 8.0' (Note Road is certified but not passable.)

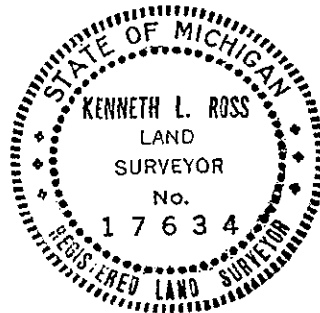

Signed by [Signature] Date Nov. 4, 1999

Surveyor's Michigan License No. 17634

Approved by Peer Review Group on Nov. 4, 1999  
 Kenneth L. Ross, County Representative [Signature]