

SURVEY & REMONUMENTATION

APR 28 1995


COMMISSION

LAND CORNER RECORDATION CERTIFICATE Filing Requirement of Act 74, Mich. P.A. 1970

For corners in

Located In: MASON (County) Corner Code # M-5

1. Public Land Survey	T	19N	R	16W	M-5
	T		R		
	T		R		
	T		R		
2. Property Controlling in Section	S		T	R	<u>Sec. 1</u>
	S		T	R	
3. Miscellaneous Property in Sec.	S		T	R	
	S		T	R	
4. Lot No. _____, Recorded Plat _____					
5. Private Claims _____					

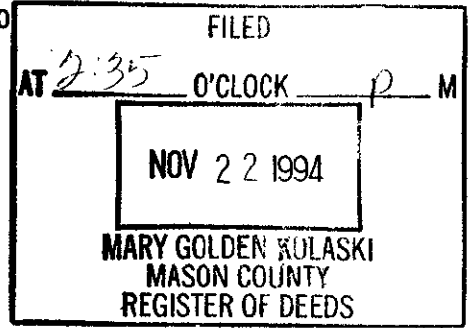

Register of Deeds Stamp & File Number

A	B	C	D	E	F	G	H	I	J	K	L	M
2	6	5	4	3	2	1						
3												
4	7	8	9	10	11	12						
5												
6	18	17	16	15	14	13						
7												
8	19	20	21	22	23	24						
9												
10	30	29	28	27	26	25						
11												
12	31	32	33	34	35	36						
13												

I, Theodore H. Weinert, in a field survey on JULY, 1994, do hereby certify that under requirements of P.A. 74, Michigan P.A. of 1970, the corner points mentioned in lines 1 and 2 above were in conformance with regulations and rules therefore as required in the current manual of survey instructions of the United States Department of the Interior, Bureau of Land Management or by a decree of a Court of Law and/or that the corner points mentioned in lines 3, 4 and 5 above were in conformance with the rules of the Michigan Board of Land Surveyors or by a Decree of a Court of Law; established, re-established, monumented, re-monumented, recovered, found as expressed below.

NOTE: Not more than 4 corners, all in the same town and range, may be recorded on this certificate.


A. Description of original monument and accessories and/or subsequent restoration:

M-5 Section Corner, Secs. 12 & 13, 19-16; 7 & 18, 19-15
 G.L.O. Notes Set Post
 July 7, 1838, Mullet & Brownfield
 10" Beech N 60 W 54 lks
 10" Hemlock S 35 W 27 lks
 August 27-29, 1888, J. A. Mitchell staked corner identified by old witnesses (Book 1, Page 199); distance from this corner south to east 1/4 corner 2638.68 feet

September, 1901, R. O. Towns set stone while completing a survey in Section 7, T.19N., R.15W. (Book 2, Page 39 & Book 3, Page 54); distance from this corner south to east 1/4 corner 2638.68 feet. August 3, 1988, Ken Ross, PLS, Pd PK Nail over iron bar; distance from this corner south to east 1/4 corner 2644.76 feet

B. Description of corner evidence found and/or method applied in restoring or reestablishing corner:

M-5 Section Corner, Secs. 12 & 13, 19-16; 7 & 18, 19-15
 Found PK Nail over iron bar
 Fit distances as described by Ken Ross, PLS.
 This corner location is accepted as a careful and faithful perpetuation of the original corner.

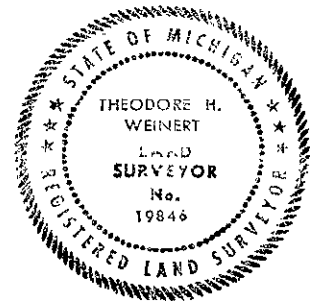

C. Description of monument for corner and accessories established to perpetuate locating the position of the corner:

M-5 Section Corner, Secs. 12 & 13, 19-16; 7 & 18, 19-15
 Set 5/8" X 36" rebar with standard 2 1/2" cap stamped "Mason County Remonumentation", in monument box.
 Spike in Power Pole N 38 E 34.44'
 Spike in Power Pole S 22 E 48.27'
 Spike in Power Pole S 46 W 46.48'
 Spike in Guy Pole N 46 W 53.18'
 CL South Schoenherr Road West 2.5'
 CL Fountain Road South 1.5'
 CL North Schoenherr Road West 10.0'

Signed by Theodore H. Weinert Date 11-6-94

Surveyor's Michigan License No. 19846 Peer Group Reviewed and Approved

LIBER 3 PAGE 218 Date: 11-5-94
Kenneth L. Ross
 Mason County Surveyor