

SURVEY & REMONUMENTATION

MAR 16 1998


SECTION

LAND CORNER RECORDATION CERTIFICATE

Filing Requirement of Act 74, Mich. P.A. 1970

For corners in

<u>MASON</u> <small>(County)</small>	Located in:	Corner Code #
1. Public Land Survey	T 19N R 16W	M-5
	T _____ R _____	_____
	T _____ R _____	_____
2. Property Controlling in Section	S _____ T _____ R _____	<i>Sec. 2</i>
	S _____ T _____ R _____	_____
3. Miscellaneous Property in Sec.	S _____ T _____ R _____	_____
	S _____ T _____ R _____	_____

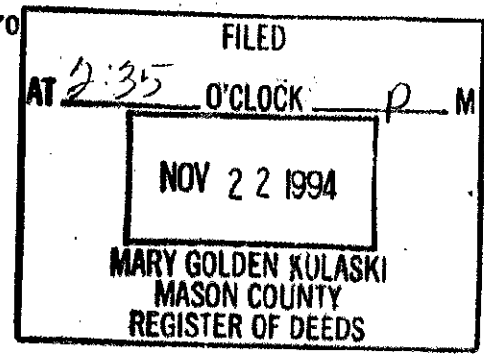

4. Lot No. _____, Recorded Plat _____
5. Private Claims _____

I, Theodore H. Weinert, in a field survey on JULY, 19 94, do hereby certify that under requirements of P.A. 74, Mich. A. of 1970, the corner points mentioned in lines 1 and 2 above were in conformance with regulations and rules therefore as required in the current manual of survey instructions of the United States Department of the Interior, Bureau of Land Management or by a decree of a Court of Law and/or that the corner points mentioned in lines 3, 4 and 5 above were in conformance with the rules of the Michigan Board of Land Surveyors or by a Decree of a Court of Law, established, re-established, monumented, re-monumented, recovered, found as expressed below:

NOTE: Not more than 4 corners, all in the same town and range, may be recorded on this certificate.


A. Description of original monument and accessories and/or subsequent restoration:

M-5 Section Corner, Secs. 12 & 13, 19-16; 7 & 18, 19-15
G.L.O. Notes Set Post
July 7, 1838, *Mullet & Brookfield*
10" Beech N 60 W 54 lks
10" Hemlock S 35 W 27 lks
August 27-29, 1888, J. A. Mitchell staked corner identified by old witnesses (Book 1, Page 199); distance from this corner south to east 1/4 corner 2638.68 feet

September, 1901, R. O. Towns set stone while completing a survey in Section 7, T.19N., R.15W. (Book 2, Page 39 & Book 3, Page 54); distance from this corner south to east 1/4 corner 2638.68 feet. August 3, 1988, Ken Ross, PLS, Pd PK Nail over iron bar; distance from this corner south to east 1/4 corner 2644.76 feet

B. Description of corner evidence found and/or method applied in restoring or reestablishing corner:

M-5 Section Corner, Secs. 12 & 13, 19-16; 7 & 18, 19-15
Found PK Nail over iron bar
Fit distances as described by Ken Ross, PLS.
This corner location is accepted as a careful and faithful perpetuation of the original corner.

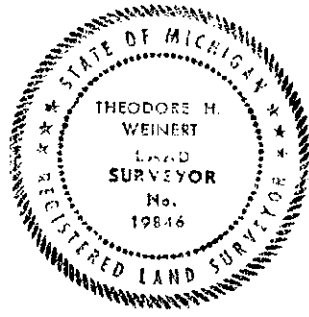

C. Description of monument for corner and accessories established to perpetuate locating the position of the corner:

M-5 Section Corner, Secs. 12 & 13, 19-16; 7 & 18, 19-15
Set 5/8" X 36" rebar with standard 2 1/2" cap stamped "Mason County Remonumentation", in monument box.
Spike in Power Pole N 38 E 34.44'
Spike in Power Pole S 22 E 48.27'
Spike in Power Pole S 46 W 46.48'
Spike in Guy Pole N 46 W 53.18'
CL South Schoenherr Road West 2.5'
CL Fountain Road South 1.5'
CL North Schoenherr Road West 10.0'

Signed by Theodore H. Weinert Date 11-6-94


FORM APPROVED BY MICHIGAN STATE BOARD OF LAND SURVEYORS, JAN. 28, 1971
REVISED MAY 14, 1975
REVISED JAN., 1983

LIBER 3 PAGE 218

Date: 11-5-94 Date: Feb 25 1997
Kenneth L. Ross Kenneth L. Ross
Mason County Surveyor Mason County Surveyor