

SURVEY & REMONUMENTATION

APR 28 1995

COMMISSION

LAND CORNER RECORDATION CERTIFICATE
Filing Requirement of Act 74, Mich. P.A. 1970

For corners in

Located In: MASON (County) Corner Code # M-7


1. Public Land Survey T 19 N R 16 W M-7
 T ___ R ___
 T ___ R ___
 T ___ R ___

2. Property Controlling S ___ T ___ R ___
 in Section S ___ T ___ R ___

3. Miscellaneous S ___ T ___ R ___
 Property in Sec. S ___ T ___ R ___

4. Lot No. _____, Recorded Plat _____

5. Private Claims _____

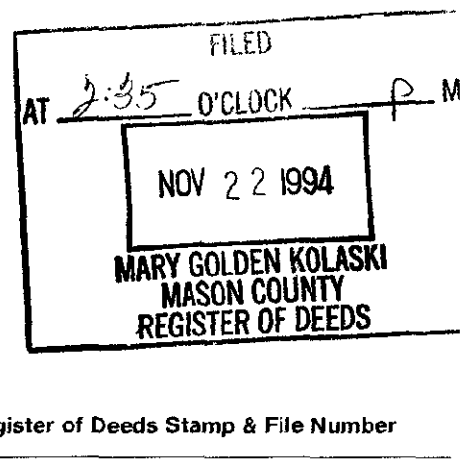

I, Theodore H. Weinert, in a field survey on JULY, 1994, do hereby certify that under requirements of P.A. 74, Michigan P.A. of 1970, the corner points mentioned in lines 1 and 2 above were in conformance with regulations and rules therefore as required in the current manual of survey instructions of the United States Department of the Interior, Bureau of Land Management or by a decree of a Court of Law and/or that the corner points mentioned in lines 3, 4 and 5 above were in conformance with the rules of the Michigan Board of Land Surveyors or by a Decree of a Court of Law; established, re-established, monumented, re-monumented, recovered, found as expressed below:

NOTE: Not more than 4 corners, all in the same town and range, may be recorded on this certificate.

A. Description of original monument and accessories and/or subsequent restoration:

M-7 Section Corner, Secs. 13 & 24, 19-16; 18 & 19, 19-15
 G.L.O. Notes Section Corner
 July 7, 1838, Sylvester Sibley
 10" Beech N 17 W 11 lks
 16" Hemlock S 14 E 8 lks
 August 27-29, 1888, J. A. Mitchell set iron rod,
 20" long, placed by competent testimony (Book 1,
 Page 199)

September, 1901, R. O. Towns Pd stone and iron
 (Book 2, Page 39 & Book 3, Page 54)
 Undated record from Sam Barnett, PLS, Pd iron pin
 and stone
 October 3, 1986, Sam Barnett, PLS, Pd iron pipe in
 monument box
 December 17, 1981, Ken Ross, PLS, Pd iron pipe in
 monument box

B. Description of corner evidence found and/or method applied in restoring or reestablishing corner:

M-7 Section Corner, Secs. 13 & 24, 19-16; 18 & 19, 19-15
 Found 1" X 15" iron pipe in monument box
 Fit old witnesses and distances as described by
 Sam Barnett, PLS, and Ken Ross, PLS.
 Fit distance within 7.0 feet as recorded by R. O.
 Towns and J. A. Mitchell.
 This corner location is accepted as a careful and
 faithful perpetuation of the original corner.


C. Description of monument for corner and accessories established to perpetuate locating the position of the corner:

M-7 Section Corner, Secs. 13 & 24, 19-16; 18 & 19, 19-15
 Set 5/8" X 36" rebar with standard 2 1/2" cap
 stamped "Mason County Remonumentation", in
 monument box.
 Spike in Guy Pole N 45 E 35.11'
 Spike in Guy Pole S 57 E 66.47'
 Spike in Guy Pole S 42 W 51.00'
 Spike in Power Pole N 46 W 42.95'
 Spike in South Post of Fence to North N 30 W
 41.80'

Signed by Theodore H. Weinert Date 11/6/94

Surveyor's Michigan License No. 19846

Peer Group Reviewed and Approved
 Date: 11-7-94
Kenneth L. Ross
 Mason County Surveyor

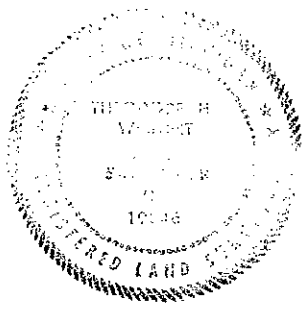

A	B	C	D	E	F	G	H	I	J	K	L	M
2	6	5	4	3	2	1						
3												
4	7	8	9	10	11	12						
5												
6	18	17	16	15	14	13						
7												
8	19	20	21	22	23	24						
9												
10	30	29	28	27	26	25						
11												
12	31	32	33	34	35	36						
13												

LIBER 3 PAGE 234