

**SURVEY & REMONUMENTATION**

MAR 16 1998

**SECTION**

**LAND CORNER RECORDATION CERTIFICATE**  
Filing Requirement of Act 74, Mich. P.A. 1970

For corners in


Located In: \_\_\_\_\_ Corner Code # \_\_\_\_\_

MASON (County)

1. Public Land Survey T 19 R 16 W M-7  
 T \_\_\_\_\_ R \_\_\_\_\_  
 T \_\_\_\_\_ R \_\_\_\_\_  
 T \_\_\_\_\_ R \_\_\_\_\_

2. Property Controlling S \_\_\_\_\_ T \_\_\_\_\_ R \_\_\_\_\_  
 in Section S \_\_\_\_\_ T \_\_\_\_\_ R \_\_\_\_\_

3. Miscellaneous S \_\_\_\_\_ T \_\_\_\_\_ R \_\_\_\_\_  
 Property in Sec. S \_\_\_\_\_ T \_\_\_\_\_ R \_\_\_\_\_

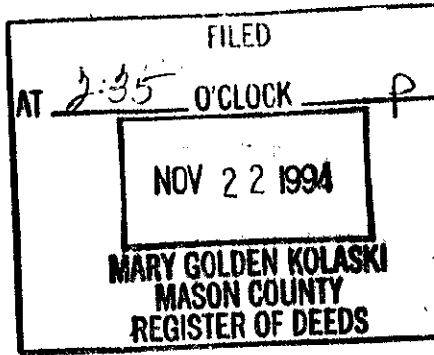

Register of Deeds Stamp & File Number

4. Lot No. \_\_\_\_\_, Recorded Plat \_\_\_\_\_  
 5. Private Claims \_\_\_\_\_

	A	B	C	D	E	F	G	H	I	J	K	L	
2	6		5		4		3		2		1		
3													
4	7		8		9		10		11		12		
5													
6	18		17		16		15		14		13		
7													
8	19		20		21		22		23		24		
9													
10	30		29		28		27		26		25		
11													
12	31		32		33		34		35		36		
13													

I, Theodore H. Weinert, in a field survey on JULY, 1994, do hereby certify that under requirements of P.A. 74, Michigan P.A. of 1970, the corner points mentioned in lines 1 and 2 above were in conformance with regulations and rules therefore as required in the current manual of survey instructions of the United States Department of the Interior, Bureau of Land Management or by a decree of a Court of Law and/or that the corner points mentioned in lines 3, 4 and 5 above were in conformance with the rules of the Michigan Board of Land Surveyors or by a Decree of a Court of Law; established, re-established, monumented, re-monumented, recovered, found as expressed below:

**NOTE: Not more than 4 corners, all in the same town and range, may be recorded on this certificate.**

**A. Description of original monument and accessories and/or subsequent restoration:**


M-7 Section Corner, Secs. 13 & 24, 19-16; 18 & 19, 19-15  
 G.L.O. Notes Section Corner  
 July 7, 1838, Sylvester Sibley  
 10" Beech N 17 W 11 lks  
 16" Hemlock S 14 E 8 lks  
 August 27-29, 1888, J. A. Mitchell set iron rod,  
 20" long, placed by competent testimony (Book 1, Page 199).  
 September, 1901, R. O. Towns Pd stone and iron (Book 2, Page 39 & Book 3, Page 54)  
 Undated record from Sam Barnett, PLS, Pd iron pin and stone  
 October 3, 1986, Sam Barnett, PLS, Pd iron pipe in monument box  
 December 17, 1981, Ken Ross, PLS, Pd iron pipe in monument box

**B. Description of corner evidence found and/or method applied in restoring or reestablishing corner:**

M-7 Section Corner, Secs. 13 & 24, 19-16; 18 & 19, 19-15  
 Found 1" X 15" iron pipe in monument box  
 Pit old witnesses and distances as described by Sam Barnett, PLS, and Ken Ross, PLS.  
 Fit distance within 7.0 feet as recorded by R. O. Towns and J. A. Mitchell.  
 This corner location is accepted as a careful and faithful perpetuation of the original corner.

**C. Description of monument for corner and accessories established to perpetuate locating the position of the corner:**

M-7 Section Corner, Secs. 13 & 24, 19-16; 18 & 19, 19-15  
 Set 5/8" X 36" rebar with standard 2 1/2" cap stamped "Mason County Remonumentation", in monument box.  
 Spike in Guy Pole N 45 E 35.11'  
 Spike in Guy Pole S 57 E 66.47'  
 Spike in Guy Pole S 42 W 51.00'  
 Spike in Power Pole N 46 W 42.95'  
 Spike in South Post of Fence to North N 30 W 41.80'

 

Peer Group Reviewed and Approved  
 Date: 11/19/94  
 Kenneth L. Ross  
 Mason County Surveyor

Signed by Theodore H. Weinert

Date 11/19/94

Surveyor's Michigan License No. 19846

Peer Group Reviewed and Approved

Date: 11-2-94  
 Kenneth L. Ross  
 Mason County Surveyor