SURVEY &
REMONUMENTATION

MAR 1 6 1998

SECTION

LAND CORNER RECORDATION CERTIFICATE

Filing Requirement of Act 74, Mich. P.A. 1970

FILED
AT 2:35 O'CLOCK p M
NOV 2 2 1994
MARY GOLDEN KOLASKI
MASON COUNTY
REGISTER OF DEEDS

Register of Deeds Stamp & File Number

For corners in

MASON (County)

		Located In:	Corner Code ##
1. Public Land Survey		T 19N R 16W	L-5
		T ___ R ___	
		T ___ R ___	
		T ___ R ___	Seg. 2
2. Property Controlling	S ___	T ___ R ___	
in Section	S ___	T ___ R ___	
3. Miscellaneous	S ___	T ___ R ___	
Property in Sec.	S ___	T ___ R ___	

4. Lot No. _____ , Recorded Plat _____
5. Private Claims _____

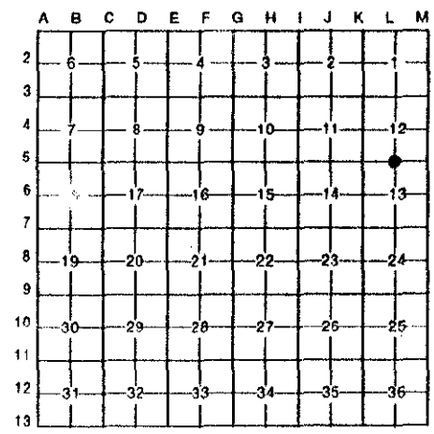

I, Theodore H. Weinert, in a field survey on JULY, 19 94, do hereby certify that under requirements of P.A. 74, Michigan P.A. of 1970, the corner points mentioned in lines 1 and 2 above were in conformance with regulations and rules therefore as required in the current manual of survey instructions of the United States Department of the Interior, Bureau of Land Management or by a decree of a Court of Law and/or that the corner points mentioned in lines 3, 4 and 5 above were in conformance with the rules of the Michigan Board of Land Surveyors or by a Decree of a Court of Law; established, re-established, monumented, re-monumented, recovered, found as expressed below:

NOTE: Not more than 4 corners, all in the same town and range, may be recorded on this certificate.

A. Description of original monument and accessories and/or subsequent restoration:

L-5 1/4 Corner, Secs. 12 & 13
G.L.O. Notes Set Section 1/4 Post
July 7, 1838, Sylvest[illegible]bley
12" Hemlock N 20 W 17
10" Hemlock S 24 E 14 lks
August 27-29, 1888, J. A. Mitchell planted a stake
3 1/2 feet (Book 1, Page 199)
May, 1903, R. O. Towns Fd Stone with X (Book 2,
Page 175).

May 19, 1992, Ken Ross, PLS, Fd PK Nail over iron .

B. Description of corner evidence found and/or method applied in restoring or reestablishing corner:

L-5 1/4 Corner, Secs. 12 & 13
Found PK Nail over 1" iron pipe.
Fit distances as described by Ken Ross, PLS.
Fit distances within 4.0 feet as recorded by R. O.
Towns.
This corner location is accepted as a careful and
faithful perpetuation of the original corner.

C. Description of monument for corner and accessories established to perpetuate locating the position of the corner:

L-5 1/4 Corner, Secs. 12 & 13
Set 5/8" X 36" rerod with standard 2 1/2" cap
stamped "Mason County Remonumentation", in
monument box.
Spike in Power Pole N 37 E 29.35'
Spike in Power Pole S 15 E 57.68'
Spike in Power Pole S 61 W 62.70'
Service Pole N 18 W 121.54'
West End of Culvert N 40 W 29.60'
East End of Culvert N 50 E 26.42'

STATE OF MICHIGAN
THEODORE H. WEINERT
SURVEYOR
No. 19846
REGISTERED LAND SURVEYOR

Peer Group Reviewed and Approved
Date: 11-7-94
Kenneth L. Ross
Mason County Surveyor

Signed by Theo H Weinert Date 11/6/94

Surveyor's Michigan License No. 19846

Peer Group Reviewed and Approved
Date: 11-7-94
[illegible]h L. Ross

FORM APPROVED BY MICHIGAN STATE BOARD OF LAND SURVEYORS, JAN. 28, 1971
REVISED MAY 14, 1975
REVISED JAN., 1983

LIBER 3 PAGE 232