

**SURVEY & REMONUMENTATION**

MAR 16 1998

**SECTION**


For corners in

MASON  
(County)

**LAND CORNER RECORDATION CERTIFICATE**  
Filing Requirement of Act 74, Mich. P.A. 1970

Located In: Corner Code #

- 1. Public Land Survey T 19N R 16W L-7
- T \_\_\_\_\_ R \_\_\_\_\_
- T \_\_\_\_\_ R \_\_\_\_\_
- T \_\_\_\_\_ R \_\_\_\_\_
- 2. Property Controlling S \_\_\_\_\_ T \_\_\_\_\_ R \_\_\_\_\_ *Leg. 2*
- in Section S \_\_\_\_\_ T \_\_\_\_\_ R \_\_\_\_\_
- 3. Miscellaneous S \_\_\_\_\_ T \_\_\_\_\_ R \_\_\_\_\_
- Property in Sec. S \_\_\_\_\_ T \_\_\_\_\_ R \_\_\_\_\_
- 4. Lot No. \_\_\_\_\_, Recorded Plat \_\_\_\_\_
- 5. Private Claims \_\_\_\_\_

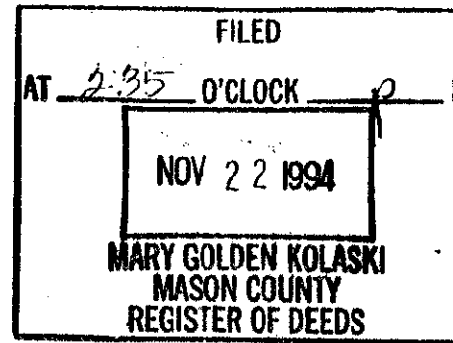

Register of Deeds Stamp & File Number

	A	B	C	D	E	F	G	H	I	J	K	L	M
2	6		5		4		3		2		1		
3													
4	7		8		9		10		11		12		
5													
6	18		17		16		15		14		13		
7													
8	19		20		21		22		23		24		
9													
10	30		29		28		27		26		25		
11													
12	31		32		33		34		35		36		
13													

I, Theodore H. Weinert, in a field survey on JULY, 1994, do hereby certify that under requirements of P.A. 74, Michigan P.A. of 1970, the corner points mentioned in lines 1 and 2 above were in conformance with regulations and rules therefore as required in the current manual of survey instructions of the United States Department of the Interior, Bureau of Land Management or by a decree of a Court of Law and/or that the corner points mentioned in lines 3, 4 and 5 above were in conformance with the rules of the Michigan Board of Land Surveyors or by a Decree of a Court of Law; established, re-established, monumented, re-monumented, recovered, found as expressed below:

**NOTE: Not more than 4 corners, all in the same town and range, may be recorded on this certificate.**

**A. Description of original monument and accessories and/or subsequent restoration:**


L-7 1/4 Corner, Secs. 13 & 24  
 G.L.O. Notes Set Quarter Section Post  
 July 7, 1838, Sylvester Sibley  
 8" Beech N 25 W 20 lks  
 8" Beech S 10 W 10 lks  
 August 27-29, 1888, J. A. Mitchell planted iron post on a split distance and on line (Book 1, Page 199)  
 Undated record from Sam Barnett, PLS, Pd iron stake Iron stake North 33.00'  
 Iron stake South 33.00' Fence Post South 30.16'  
 none of these witnesses remain  
 October 3, 1986, Sam Barnett, PLS, Pd iron pin in monument box witness given one of which remains  
 December 17, 1981, Ken Ross, PLS, Pd iron in monument box no witness

**B. Description of corner evidence found and/or method applied in restoring or reestablishing corner:**

L-7 1/4 Corner, Secs. 13 & 24  
 Found 1" Axle Shaft in monument box  
 Attempted to remove this iron with no success, left in place.  
 Fit distances East and West as described in the surveys by Sam Barnett, PLS, & Ken Ross, PLS.  
 Fit distances east and west within 7.0 feet as recorded by J. A. Mitchell  
 This corner location is accepted as a careful and faithful perpetuation of the original corner.

**C. Description of monument for corner and accessories established to perpetuate locating the position of the corner:**

L-7 1/4 Corner, Secs. 13 & 24  
 1" Axle Shaft in monument box.  
 Spike in Power Pole N 20 E 32.40'  
 CL Steel I-Beam Post S 14 E 24.80'  
 NE Corner Wood Porch S 25 W 68.58'  
 CL 18" Maple S 53 W 41.20'  
 On CL Millerton Road

 

Peer Group Reviewed and Approved  
 Date: 11/16/94  
 Mason County Surveyor

Signed by Theodore H. Weinert Date 11/16/94  
 Surveyor's Michigan License No. 19846

Peer Group Reviewed and Approved  
 Date: 11-7-94  
 Kenneth L. Ross  
 Mason County Surveyor