SURVEY & REMONUMENTATION

MAR 1 6 1998

SECTION

LAND CORNER RECORDATION CERTIFICATE

Filing Requirement of Act 74, Mich. P.A. 1970

FILED AT 2:35 O'CLOCK P M

NOV 2 2 1994

MARY GOLDEN KOLASKI
MASON COUNTY
REGISTER OF DEEDS

Register of Deeds Stamp & File Number

For corners in MASON (County)

	Located In:	Corner Code #
1. Public Land Survey	T 19N R 16W	K-7
	T ___ R ___	
	T ___ R ___	
	T ___ R ___	Seg. 2
2. Property Controlling	S ___ T ___ R ___	
in Section	S ___ T ___ R ___	
3. Miscellaneous	S ___ T ___ R ___	
Property in Sec.	S ___ T ___ R ___	

4. Lot No. _____, Recorded Plat _____
5. Private Claims _____

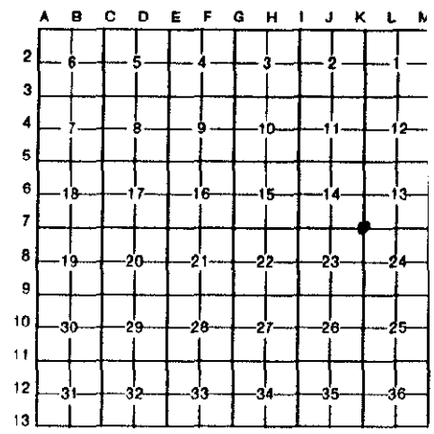

I, Theodore H. Weinert, in a field survey on JULY, 19 94, do hereby certify that under requirements of P.A. 74, Michigan P.A. of 1970, the corner points mentioned in lines 1 and 2 above were in conformance with regulations and rules therefore as required in the current manual of survey instructions of the United States Department of the Interior, Bureau of Land Management or by a decree of a Court of Law and/or that the corner points mentioned in lines 3, 4 and 5 above were in conformance with the rules of the Michigan Board of Land Surveyors or by a Decree of a Court of Law; established, re-established, monumented, re-monumented, recovered, found as expressed below:

NOTE: Not more than 4 corners, all in the same town and range, may be recorded on this certificate.

A. Description of original monument and accessories and/or subsequent restoration:

K-7 Section Corner, Secs. 13, 14, 23 & 24
G.L.O. Notes Set Post
July 7, 1838, Sylvester Sibley
10" Beech S 55 W 11 lks
6" Sugar N 56 E 20 lks
August 27-29, 1888, J. A. Mitchell identified corner by competent testimony and planted stake and irons (Book 1, Page 199)
2 R.R. links and couplings in center
May, 1902, R. O. Towns Fd stone and iron (Book 2, Page 31 & Book 2, Page 78)
Undated record from Sam Barnett, PLS, Fd 1" iron and piece of coal, witness given with two left in place NW Corner House S 51 E 90.8'
2" Tree S 45.5 W 39.80' now 30" Maple
Ken Ross, PLS, Fd 60d spike set in 1/2" iron rod, fit witnesses given 2 out of 3

B. Description of corner evidence found and/or method applied in restoring or reestablishing corner:

K-7 Section Corner, Secs. 13, 14, 23 & 24
Found 1/2" X 24" iron rod in monument box
Fit witness and distance to east as described by Ken Ross, PLS.
Fit distance to east within 7.0 feet as recorded by R. O. Towns and J. A. Mitchell.
This corner location is accepted as a careful and faithful perpetuation of the original corner.

C. Description of monument for corner and accessories established to perpetuate locating the position of the corner:

K-7 Section Corner, Secs. 13, 14, 23 & 24
Set 5/8" X 36" rerod with standard 2 1/2" cap stamped " Mason County Remonumentation".
Spike in 6" X 6" Cor Post N 53 E 58.95'
Spike in East Post of Guard Rail S 64 E 51.58'
NW Corner House S 51 E 90.80'
Spike in Power Pole S 42 E 43.48'
CL 30" Maple S 50 W 39.90'
Spike in Power Pole N 43 W 46.41'

STATE OF MICHIGAN
THEODORE H. WEINERT
LICENSED SURVEYOR
No. 19846
REGISTERED LAND SURVEYOR

Peer Group Reviewed and Approved
Date: 11-22-94
Kenneth L. Ross
Mason County Surveyor

Signed by Theodore H. Weinert Date 11/6/94

Surveyor's Michigan License No. 19846

Peer Group Reviewed and Approved
Date: 11-2-94
Kenneth L. Ross

FORM APPROVED BY MICHIGAN STATE BOARD OF LAND SURVEYORS, JAN. 28, 1971
REVISED MAY 14, 1975
REVISED JAN., 1983

LIBER 3 PAGE 230