

# SURVEY & REMONUMENTATION


MAY 07 1997

## COMMISSION

### LAND CORNER RECORDATION CERTIFICATE Filing Requirement of Act 74, Mich. P.A. 1970

For corners in

Mason (County)	Located In:	Corner Code #
1. Public Land Survey	T 19N R 18W	M-03
	T 19N R 17W	A-03 ✓ Same corner
	T R	
	T R	
2. Property Controlling in Section	S T R	
	S T R	
3. Miscellaneous Property in Sec.	S T R	
	S T R	

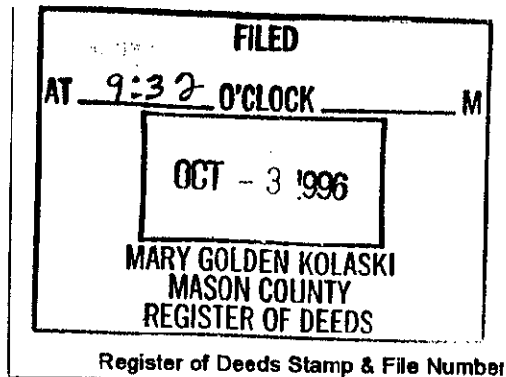

4. Lot No. \_\_\_\_\_, Recorded Plat \_\_\_\_\_  
5. Private Claims \_\_\_\_\_

I, Sammy S. Barnett, in a field survey on Sept. 11, 1996 do hereby state that under requirements of P.A. 74, Michigan P.A. of 1970, the corner points mentioned in lines 1 and 2 above were in conformance with regulations and rules therefore as required in the current manual of survey instructions of the United States Department of the Interior, Bureau of Land Management or by a decree of a Court of Law and /or that the corner points mentioned in lines 3, 4 and 5 above were in conformance with the rules of the Michigan Board of Land Surveyors or by a Decree of a Court of Law; established, re-established, monumented, recovered, found as expressed below:

NOTE: Not more than 2 corners, all in the same town and range, may be recorded on this certificate.

A	B	C	D	E	F	G	H	I	J	K	L
1											
2	6		5		4		3		2		1
3											
4	7		8		9		10		11		12
5											
6	18		17		16		15		14		13
7											
8	19		20		21		22		23		24
9											
10	30		29		28		27		26		25
11											
12	31		32		33		34		35		36
13											

**A. Description of original monument and accessories and/or subsequent restoration:**

M-03 & A-03 corner common to sections 1 & 12 T19N, R18W (Hamlin) & sections 6 & 7 T19N, R17W (Victory) same corner 1838 Mullett & Brookfield G.L.D.

- |                                    |                                 |                                       |
|------------------------------------|---------------------------------|---------------------------------------|
| Set post                           | Set 1 1/2" pipe                 | #7 Maple 16" S70W 15.14'              |
| #1 Sugar 10" S21W 43 lks. (28.38') | #3 Beech 20" W. 54.2'           | #8 Tw. Beech 24" S17W 63.50'          |
| #2 Beech 9" N35W 19 lks. (12.54')  | #4 Hemlock 20" N 12.0'          | #9 P.K. in end of Asp. Dr. S37W 7.21' |
| 1887 J. Mitchell                   | #5 Maple 24" NNW 9.7'           | 1994 K. Ross                          |
| Monument not given                 | 1974 K. Ross Act 74 L 1. P 265  | Monument not given                    |
| Witnesses trees still standing     | Found 1 1/2" Pipe               | #10 Capped iron 10' East              |
| 1959 K.B. Stephens                 | #6 Hemlock 18" N12E 13.0' (#4 ) |                                       |

**B. Description of corner evidence found and/or method applied in restoring or reestablishing corner:**

M-03 & A-03 corner common to sections 1 & 12 T19N, R18W (Hamlin) & sections 6 & 7 T19N, R17W (Victory) same corner  
On Sept. 11, I found 1 1/2" pipe. I found no evidence to dispute this location. The condition of the recorded witnesses are;

- |  |  |
|--|--|
| # 1 Gone                                     | # 8 Tw. Beech 24" S17W 63.50' spike in SW side |
| # 2 Gone                                     | # 9 P.K. in end of Asp. Dr. S37W 7.21'         |
| # 3 Beech 26" W. 54.2'                       | # 10 Capped iron 10" East                      |
| # 4 Hemlock 20" N06E 13.01' spike in NW side |  |
| # 5 cut off                                  |  |
| # 6 same as # 4                              |  |
| # 7 Cut off                                  |  |

**C. Description of monument for corner and accessories established to perpetuate locating the position of the corner:**


M-03 & A-03 corner common to sections 1 & 12 T19N, R18W (Hamlin) & sections 6 & 7 T19N, R17W (Victory) same corner

I replaced the 1 1/2" pipe, in the exact location, with a Standard Mason County Monument and accepted this location as a careful and faithful reestablishment of the original corner.

- # 4 Hemlock 20" N06E 13.01' spike in NW side
- # 8 Tw. Beech 24" S17W 63.50' spike in SW side
- # 9 P.K. in end of Asp. Dr. S37W 7.21'
- # 10 capped iron East 10.0'
- # 11 Maple 10" S75W 38.19' spike in SE side
- # 12 Power Pole N23W 12.15' spike in NE side

Signed by Sammy S. Barnett  
Surveyor's Michigan License No. 16923

Date 9-28-96

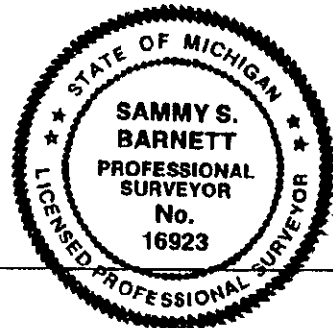

Peer Group Reviewed and Approved  
Date: 9-30-96  
Kenneth L. Koss  
Mason County Surveyor