

**SURVEY &  
REMONUMENTATION**


MAY 07 1997

**COMMISSION**

**LAND CORNER RECORDATION CERTIFICATE  
Filing Requirement of Act 74, Mich. P.A. 1970**

For corners in

<u>Mason</u> (County)	Located in:	Corner Code #	
1. Public Land Survey	T 19N R 18W	M-04	
	T 19N R 17W	A-04	✓ Same corner
	T _____ R _____	_____	_____
	T _____ R _____	_____	_____
2. Property Controlling In Section	S _____ T _____	_____	_____
	S _____ T _____	_____	_____
3. Miscellaneous Property in Sec.	S _____ T _____	_____	_____
	S _____ T _____	_____	_____

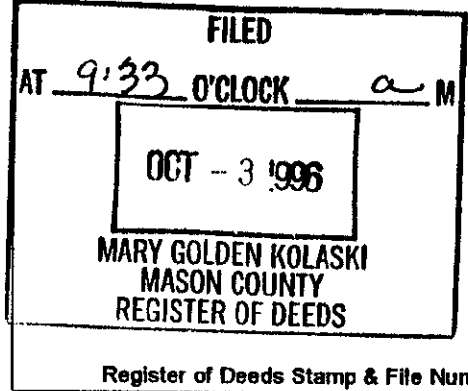

4. Lot No. \_\_\_\_\_, Recorded Plat \_\_\_\_\_  
5. Private Claims \_\_\_\_\_

I, Sammy S. Barnett, in a field survey on Sept, 19 96 do hereby state that under requirements of P.A. 74, Michigan P.A. of 1970, the corner points mentioned in lines 1 and 2 above were in conformance with regulations and rules therefore as required in the current manual of survey instructions of the United States Department of the Interior, Bureau of Land Management or by a decree of a Court of Law and /or that the corner points mentioned in lines 3, 4 and 5 above were in conformance with the rules of the Michigan Board of Land Surveyors or by a Decree of a Court of Law; established, re-established, monumented, recovered, found as expressed below:

**NOTE:** Not more than 2 corners, all in the same town and range, may be recorded on this certificate.

	A	B	C	D	E	F	G	H	I	J	K	L
1												
2		6		5		4		3		2		1
3												
4		7		8		9		10		11		12
5												
6		10		17		16		15		14		13
7												
8		19		20		21		22		23		24
9												
10		30		29		28		27		26		25
11												
12		31		32		33		34		35		36
13												

**A. Description of original monument and accessories and/or subsequent restoration:**

M-04 & A-04 Corner common to section 12, T19N, R18W (Hamlin) & section 4, T19N, R17W (Victory) same corner  
1838 Mullett & Brookfield G.L.O.      1991 K. Ross  
Set post      Found large eye bolt  
#1 Sugar 8" N21W 20 lks (13.20')      #3 Maple 12" N31W 38.65'  
#2 Hemlock 8" S50W 23 lks. (15.18')      #4 Maple 12" S68E 23.09'  
1880 & 1887 J. Mitchell      #5 Maple 10" S35E 33.88"  
Monument not given      2' E. Cen. Rd. on fence to East  
Witness trees standing  
Undated M.C.R.C. Iron. no witnesses

**B. Description of corner evidence found and/or method applied in restoring or reestablishing corner:**

M-04 & A-04 Corner common to section 12, T19N, R18W (Hamlin) & section 4, T19N, R17W (Victory) same corner  
On Sept 11, I found 1/2" eye bolt 24" long 2' W. of centerline of road old fence E & W. I found no evidence to dispute this location. The condition of the recorded witnesses are;  
# 1 Gone  
# 2 Gone  
# 3 Maple 14" N31W 38.70' spike in SW side  
# 4 Maple 13" S68E 23.09' spike in SW side  
# 5 Maple 11" S35E 33.88' spike in SW side

**C. Description of monument for corner and accessories established to perpetuate locating the position of the corner:**

M-04 & A-04 Corner common to section 12, T19N, R18W (Hamlin) & section 4, T19N, R17W (Victory) same corner  
I replaced the 1/2" eye bolt. in the exact location, with a Standard Mason County Monument and accepted this location as a careful and faithful reestablishment of the original corner.  
# 3 Maple 14" N31W 38.70' spike in SW side  
# 4 Maple 13" S68E 23.09' spike in SW side  
# 5 Maple 11" S35E 33.88' spike in SW side  
# 6 Maple 15" S18W 44.38' spike in SE side

Signed by Sammy S. Barnett  
Surveyor's Michigan License No. 16923

Date 9-28-96



Peer Group Reviewed  
and Approved  
Date: 9-30-96  
Kenneth L. Ross  
Mason County Surveyor