

**SURVEY &
REMONUMENTATION**


MAY 07 1997

COMMISSION

**LAND CORNER RECORDATION CERTIFICATE
Filing Requirement of Act 74, Mich. P.A. 1970**

For corners in

Mason	Located In:	Corner Code #
(County)		
1. Public Land Survey	T 19N R 18W	M-07
	T 19N R 17W	✓ A-07 Same corner
	T R	
	T R	
2. Property Controlling in Section	S T R	
	S T R	
3. Miscellaneous Property in Sec.	S T R	
	S T R	

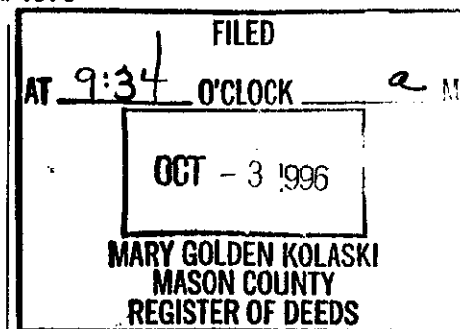

Register of Deeds Stamp & File Number

4. Lot No. _____, Recorded Plat _____
5. Private Claims _____

I, Sammy S. Barnett, in a field survey on Sept., 1996 do hereby state that under requirements of P.A. 74, Michigan P.A. of 1970, the corner points mentioned in lines 1 and 2 above were in conformance with regulations and rules therefore as required in the current manual of survey instructions of the United States Department of the Interior, Bureau of Land Management or by a decree of a Court of Law and/or that the corner points mentioned in lines 3, 4 and 5 above were in conformance with the rules of the Michigan Board of Land Surveyors or by a Decree of a Court of Law; established, re-established, monumented, recovered, found as expressed below:

NOTE: Not more than 2 corners, all in the same town and range, may be recorded on this certificate.

A	B	C	D	E	F	G	H	I	J	K	L	M
1												
2	6	5	4	3	2	1						
3												
4	7	8	9	10	11	12						
5												
6	18	17	16	15	14	13						
7												
8	19	20	21	22	23	24						
9												
10	30	29	28	27	26	25						
11												
12	31	32	33	34	35	36						
13												

A. Description of original monument and accessories and/or subsequent restoration:

M-07 & A-07 corner common to sections 13 & 24 T19N, R18W (Hamlin) & sections 18 & 19, T19N, R17W (Victory) same corner 1838 Mullett & Brookfield G.L.O.

- | | | |
|--------------------------------------|-------------------------|--------------------------------|
| Set post | #3 Beech 15" N.W. 48.6' | #8 Beech 16" N.W. 47.85' (# 3) |
| #1 W. Pine 24" S18W 74 lks. (48.84') | #4 Elm 12" N. 48.4' | #9 Maple 5" S. 42.23' |
| #2 Beech 10" N78W 45 lks. (29.70") | #5 Elm 15" S. 30.2' | |
| 1889 C.E. Mitchell | #6 Elm 12" S.E. 60.55' | |
| Stake, by old witnesses | 1968 K.B. Stephens | |
| Undated M.C.R.C. | Found 1/2" iron pin | |
| 1/2" iron over 1" iron | #7 Ash 10" N.E. 96.48' | |

B. Description of corner evidence found and/or method applied in restoring or reestablishing corner:

M-07 & A-07 corner common to sections 13 & 24 T19N, R18W (Hamlin) & sections 18 & 19, T19N, R17W (Victory) same corner On Sept 12, I found 3/4" iron rod 1' S. of C/L road I found no evidence to dispute this location. The condition of the recorded witnesses are;


- | | |
|----------|----------|
| # 1 Gone | # 8 Gone |
| # 2 Gone | # 9 Gone |
| # 3 Dead | |
| # 4 Gone | |
| # 5 Gone | |
| # 6 Gone | |
| # 7 Gone | |

C. Description of monument for corner and accessories established to perpetuate locating the position of the corner:

M-07 & A-07 corner common to sections 13 & 24 T19N, R18W (Hamlin) & sections 18 & 19, T19N, R17W (Victory) same corner

I replaced the 3/4" iron, in the exact location, with a Standard Mason County Monument and accepted this location as a careful and faithful reestablishment of the original corner (in mon box)

- # 10 Maple 10" N48E 63.72' spike in SE side
- # 11 Power pole N63W 79.62' spike in SW side
- # 12 Black Ash 8" S51W 47.92' spike in SE side
- # 13 Black Ash 6" S22W 34.80' spike in SE side

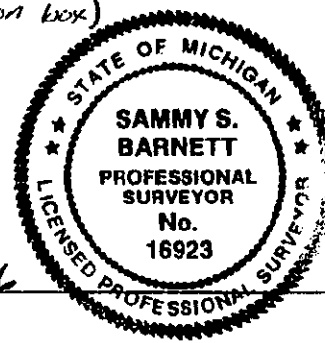

Signed by Sammy S. Barnett
Surveyor's Michigan License No. 16923

Date 9-28-96

Peer Group Reviewed and Approved
Date: 9-30-96
Kenneth L. Ross
Mason County Surveyor