

**SURVEY &  
REMONUMENTATION**

MAR 16 1998

**LAND CORNER RECORDATION CERTIFICATE**

Filing Requirement of Act 74, Mich. P.A. 1970

**SECTION**

For corners in

MASON  
(County)

Located in:

Corner Code #

1. Public Land Survey

T 19N R 17W

B-13

T \_\_\_\_\_ R \_\_\_\_\_

T \_\_\_\_\_ R \_\_\_\_\_

T \_\_\_\_\_ R \_\_\_\_\_

2. Property Controlling  
in Section

S \_\_\_\_\_ T \_\_\_\_\_ R \_\_\_\_\_

S \_\_\_\_\_ T \_\_\_\_\_ R \_\_\_\_\_


3. Miscellaneous  
Property in Sec.

S \_\_\_\_\_ T \_\_\_\_\_ R \_\_\_\_\_

S \_\_\_\_\_ T \_\_\_\_\_ R \_\_\_\_\_

4. Lot No. \_\_\_\_\_, Recorded Plat \_\_\_\_\_

5. Private Claims \_\_\_\_\_

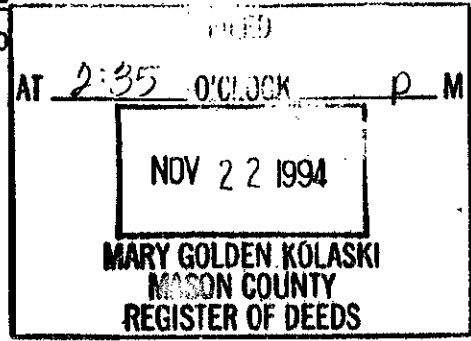

Register of Deeds Stamp & File Number

	A	B	C	D	E	F	G	H	I	J	K	L	M
2	6		5		4		3		2		1		
3													
4	7		8		9		10		11		12		
5													
6	18		17		16		15		14		13		
7													
8	19		20		21		22		23		24		
9													
10	30		29		28		27		26		25		
11													
12	31		32		33		34		35		36		
13													

I, Theodore H. Weinert, in a field survey on JULY, 1994, do hereby certify that under requirements of P.A. 74, Michigan P.A. of 1970, the corner points mentioned in lines 1 and 2 above were in conformance with regulations and rules therefore as required in the current manual of survey instructions of the United States Department of the Interior, Bureau of Land Management or by a decree of a Court of Law and/or that the corner points mentioned in lines 3 and 5 above were in conformance with the rules of the Michigan Board of Land Surveyors or by a Decree of a Court of Law; established, re-established, monumented, re-monumented, recovered, found as expressed below:

**NOTE: Not more than 4 corners, all in the same town and range, may be recorded on this certificate.**

**A. Description of original monument and accessories and/or subsequent restoration:**

B-13 1/4 Corner, Sec. 31

G.L.O. Notes Set Post  
1838 Sylvester Sibley  
12" Beech N 64 W 50 lks  
9" Sugar N 30 E 37 lks  
1974 T. Weinert reestablished corner based on  
occupation to the north and competent testimony  
August 21, 1975, James T. Nordlund, PLS, tied into  
corner

October 4, 1977, Ken Ross, PLS, tied into corner  
1989 T. Weinert for MCRC tied into corner

**B. Description of corner evidence found and/or method applied in restoring or reestablishing corner:**


B-13 1/4 Corner, Sec. 31

Found 3/8" X 18" pipe.  
As set by T. Weinert.  
This corner location is accepted as the best  
available evidence of the original corner.

**C. Description of monument for corner and accessories established to perpetuate locating the position of the corner:**

B-13 1/4 Corner, Sec. 31

Replaced 3/8" X 18" pipe with 5/8" X 36" rebar  
with standard 2 1/2" cap stamped "Mason County  
Remonumentation".  
8" Soft Maple East 17.52'  
Guy Pole N 55 E 32.51'  
Tri Cherry N 27 W 20.53'  
6" Cherry S 85 W 17.43'  
6" Soft Maple S 40 E 21.54'  
N 1/4 Corner Section 6, T18N, R17W, East 15.75'

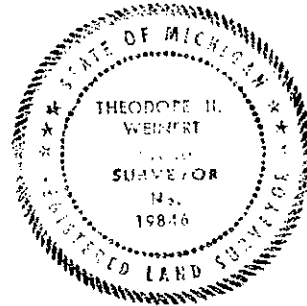

Signed by

*Theodore H. Weinert*

Date

10/4/99

Surveyor's Michigan License No.

19846

LIBER

3 PAGE 222

Peer Group Reviewed FORM APPROVED BY MICHIGAN STATE BOARD OF LAND SURVEYORS, JAN. 28, 1971  
and Approved

Date: 10-5-99 *Kenneth E. Ross*

Date: 10-5-99 *Kenneth E. Ross*