

SURVEY & REMONUMENTATION

MAR 16 1998

SECTION

LAND CORNER RECORDATION CERTIFICATE
 Filing Requirement of Act 74, Mich. P.A. 1970

For corners in


MASON
 (County)

Located In:

Corner Code #

- | | | | | | |
|------------------------------------|---|------------|---|------------|------|
| 1. Public Land Survey | T | <u>19N</u> | R | <u>17W</u> | C-12 |
| | T | | R | | |
| | T | | R | | |
| | T | | R | | |
| | T | | R | | |
| 2. Property Controlling In Section | S | | T | R | |
| | S | | T | R | |
| 3. Miscellaneous Property In Sec. | S | | T | R | |
| | S | | T | R | |

Sec. 2

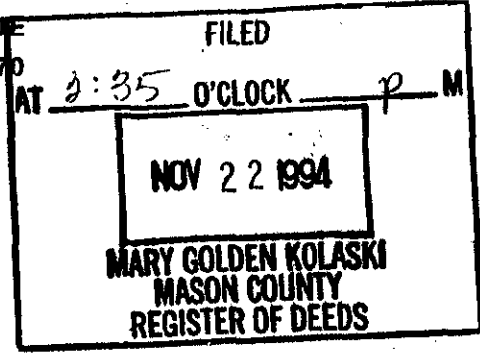

Register of Deeds Stamp & File Number

4. Lot No. _____, Recorded Plat _____
 5. Private Claims _____

I, Theodore H. Weinert, in a field survey on OCTOBER, 1994, do hereby certify that under requirements of P.A. 74, Michigan P.A. of 1970, the corner points mentioned in lines 1 and 2 above were in conformance with regulations and rules therefore as required in the current manual of survey instructions of the United States Department of the Interior, Bureau of Land Management or by a decree of a Court of Law and/or that the corner points mentioned in lines 3, 4 and 5 above were in conformance with the rules of the Michigan Board of Land Surveyors or by a Decree of a Court of Law; established, re-established, monumented, re-monumented, recovered, found as expressed below:

	A	B	C	D	E	F	G	H	I	J	K	L	M
2	6	5	4	3	2	1							
3													
4	7	8	9	10	11	12							
5													
6	18	17	16	15	14	13							
7													
8	19	20	21	22	23	24							
9													
10	30	29	28	27	26	25							
11													
12	31	32	33	34	35	36							
13													

NOTE: Not more than 4 corners, all in the same town and range, may be recorded on this certificate.

A. Description of original monument and accessories and/or subsequent restoration:

C-12 1/4 Corner, Secs. 31 & 32
 G.L.O. Notes Set Post

1974 T. Weinert Pd iron on an uncompleted survey
 No other records found between 1899 and 1974


14" Beech at Corner
 No witness taken (Page 413)
 May, 1899, R. O. Towns identified corner as a stone (Book 2, Page 45 & Book 4, Page 2)
 1985 Ken Ross, PLS, Pd iron while completing a survey for the Mason County Road Commission

B. Description of corner evidence found and/or method applied in restoring or reestablishing corner:

C-12 1/4 Corner, Secs. 31 & 32
 Found T iron next to 3/4" iron bar.
 Location of the iron matched distances as described by R. O. Towns, Ken Ross, PLS, and T. Weinert.
 This corner location is accepted as a careful and faithful perpetuation of the original corner.

C. Description of monument for corner and accessories established to perpetuate locating the position of the corner:

C-12 1/4 Corner, Secs. 31 & 32
 Set 5/8" X 24" rerod with standard 2 1/2" cap stamped "Mason County Remonumentation" next to and in between the T iron and 3/4" iron bar.
 Spike in Guy Pole S 66 E 41.94'
 Spike in 6" Maple S 20 W 92.09'
 2" Steel Fence Post S 30 E 33.04'
 Guy Pole N 33 W 78.61'
 P. Pole N 46 E 53.87'

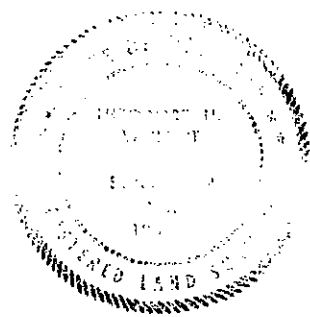

Peer Group Reviewed and Approved
 Date: 11/6/94
 Kenneth L. Ross
 Mason County Surveyor

Signed by *Therese A. Ross* Date 11/6/94

Surveyor's Michigan License No. 19846 Peer Group Reviewed

Date: 11-2-94

Kenneth L. Ross
 Mason County Surveyor