


SURVEY & REMONUMENTATION

APR 28 1995

LAND CORNER RECORDATION CERTIFICATE Filing Requirement of Act 74, Mich. P.A. 1970

For corners in _____
COMMISSION

MASON <small>(County)</small>	Located In:	Corner Code #	
1. Public Land Survey	T <u>19N</u> R <u>17W</u>	C-13	
	T _____ R _____		
	T _____ R _____		
	T _____ R _____		
2. Property Controlling in Section	S _____ T _____ R _____		
	S _____ T _____ R _____		
3. Miscellaneous Property in Sec.	S _____ T _____ R _____		
	S _____ T _____ R _____		
4. Lot No. _____, Recorded Plat _____			
5. Private Claims _____			

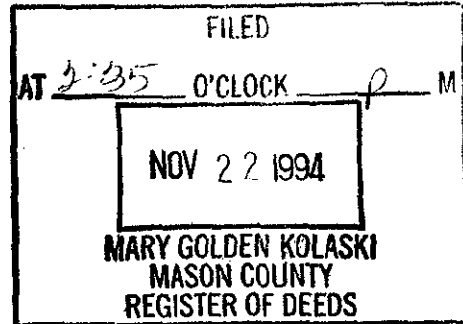

Register of Deeds Stamp & File Number

I, Theodore H. Weinert in a field survey on JULY, 1994, do hereby certify that under requirements of P.A. 74, Michigan P.A. of 1970, the corner points mentioned in lines 1 and 2 above were in conformance with regulations and rules therefore as required in the current manual of survey instructions of the United States Department of the Interior, Bureau of Land Management or by a decree of a Court of Law and/or that the corner points mentioned in lines 3, 4 and 5 above were in conformance with the rules of the Michigan Board of Land Surveyors or by a Decree of a Court of Law; established, re-established, monumented, re-monumented, recovered, found as expressed below:

NOTE: Not more than 4 corners, all in the same town and range, may be recorded on this certificate.

	A	B	C	D	E	F	G	H	I	J	K	L	M
2	6	5	4	3	2	1							
3													
4	7	8	9	10	11	12							
5													
6	18	17	16	15	14	13							
7													
8	19	20	21	22	23	24							
9													
10	30	29	28	27	26	25							
11													
12	31	32	33	34	35	36							
13													

A. Description of original monument and accessories and/or subsequent restoration:

C-13 Section Corner, Secs. 31 & 32

G.L.O. Notes Set Post in Cedar swamp
September, 1838, Sylvester Sibley
24 lks West of NE Corner Section 6, T18N, R17W
(See Back for Sketch)
14" B. Ash N 31 E 23 lks
10" B. Ash N 27 W 24 lks

May, 1899, & December, 1899, R. O. Towns Pd old government stake (Book 2, Page 32 & Book 3, Page 2)
December, 1899, R. O. Towns Pd corner 65 lks west of the NW corner of Section 5, T18N, R17W

B. Description of corner evidence found and/or method applied in restoring or reestablishing corner:

C-13 Section Corner, Secs. 31 & 32


No corner found.
Reestablished corner 65 lks (42.90') west of the NW corner of Section 5, T18N, R17W, as called for by R. O. Towns.
This position fits the swamp calls as stated in the original government survey by Sibley.
Swamp calls as per Sibley
West along South line Section 31, 2 chains left swamp. North along East line 6 chains left swamp.
This corner location is accepted as a careful and faithful perpetuation of the original corner.

C. Description of monument for corner and accessories established to perpetuate locating the position of the corner:

C-13 Section Corner, Secs. 31 & 32

Set 1" X 6' I.D. pipe with 5/8" X 18" rebar set inside with standard 2 1/2" cap stamped "Mason County Remonumentation".
Cedar Post S 42 E 4.91'
Cedar Post S 40 W 6.39'
14" Hemlock S 82 W 107.04'
5/8" X 18" iron bar with cap 19846 N 89-02-48 W 132.00' (2 chains) on edge of swamp as per G.L.O. notes
5/8" X 18" iron bar with cap 19846 N 02-48-31 W 396.00' (9 chains) as per G.L.O. notes

Corner Common to Sections 5 & 6, T18N, R17W, East 42.90'

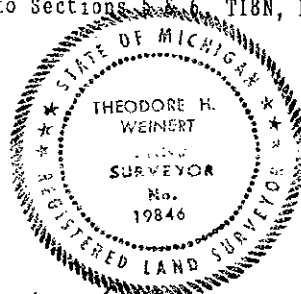

Signed by Theodore H. Weinert

Date 10/4/94

Surveyor's Michigan License No. 19846

Peer Group Reviewed and Approved
Date: 10-5-94
Kenneth L. Ross
Mason County Surveyor

APPROVED BY MICHIGAN STATE BOARD OF LAND SURVEYORS, JAN. 28, 1971
REVISED MAY 14, 1975
REVISED JAN., 1983