

**LAND CORNER RECORDATION CERTIFICATE**  
**Filing Requirement of Act 74, Mich. P.A. 1970**

For corners in

<u>MASON</u> (County)	Located In:	Corner Code #/
1. Public Land Survey	T <u>19N</u> R <u>17W</u>	D-13
	T _____ R _____	_____
	T _____ R _____	_____
	T _____ R _____	_____
2. Property Controlling in Section	S _____ T _____ R _____	_____
	S _____ T _____ R _____	_____
3. Miscellaneous Property in Sec.	S _____ T _____ R _____	_____
	S _____ T _____ R _____	_____

4. Lot No. \_\_\_\_\_, Recorded Plat \_\_\_\_\_  
 5. Private Claims \_\_\_\_\_

I, Theodore H. Weinert, in a field survey on JULY, 1994, do hereby certify that under requirements of P.A. 74, Michigan P.A. of 1970, the corner points mentioned in lines 1 and 2 above were in conformance with regulations and rules therefore as required in the current manual of survey instructions of the United States Department of the Interior, Bureau of Land Management or by a decree of a Court of Law and/or that the corner points mentioned in lines 3, 4 and 5 above were in conformance with the rules of the Michigan Board of Land Surveyors or by a Decree of a Court of Law; established, re-established, monumented, re-monumented, recovered, found as expressed below:

**NOTE: Not more than 4 corners, all in the same town and range, may be recorded on this certificate.**

**A. Description of original monument and accessories and/or subsequent restoration:**


D-13 S. 1/4 Corner, Sec. 32  
 G.L.O. Notes Set Post  
 1838 Sylvester Sibley  
 14" Beech N 41 W 30 lks  
 18" Beech N 50 E 40 lks  
 May, 1899, R. O. Towns Pd stake set by former surveyor (Book 2, Page 45 & Book 4, Page 2)

**B. Description of corner evidence found and/or method applied in restoring or reestablishing corner:**

D-13 S. 1/4 Corner, Sec. 32  
 Set 5/8" X 36" rebar on a prorated distance based on the above described survey completed by R. O. Towns, between the SW corner and the SE corner of section 32. Trace of fence to north line. Fence line E-W at this location.  
 This corner location is accepted as a careful and faithful perpetuation of the original corner.


**C. Description of monument for corner and accessories established to perpetuate locating the position of the corner:**

D-13 S. 1/4 Corner, Sec. 32  
 Set 5/8" X 36" rebar with standard 2 1/2" cap stamped "Mason County Renonumentation".  
 8" Maple S 86 E 24.94'  
 Tri Maple N 16 E 6.40'  
 15" Maple N 61 W 23.54'  
 12" Maple S 57 W 24.15'  
 8" Maple S 21 W 36.67'  
 N 1/4 Corner Section 5, T18N, R17W, East 91.47'

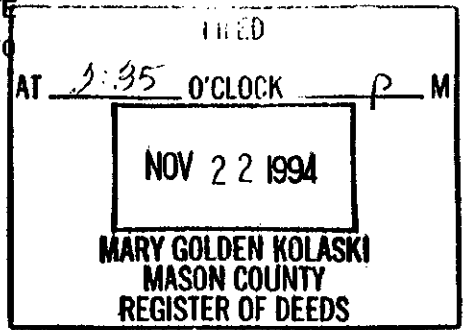

Register of Deeds Stamp & File Number

	A	B	C	D	E	F	G	H	I	J	K	L	M
2	6	5	4	3	2	1							
3													
4	7	8	9	10	11	12							
5													
6	18	17	16	15	14	13							
7													
8	19	20	21	22	23	24							
9													
10	30	29	28	27	26	25							
11													
12	31	32	33	34	35	36							
13													

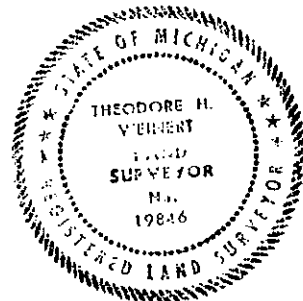

Signed by Theodore H. Weinert  
 Surveyor's Michigan License No. 19846

Date 10-4/94

Peer Group Review Form Approved by Michigan State Board of Land Surveyors, Jan. 26, 1971  
 and Approved, Date: 10-4-94  
 Kenneth L. Ross  
 Mason County Surveyor

REVISOR MAY 14, 1975  
 REVISED JAN. 1993