


# SURVEY & REMONUMENTATION

APR 28 1995

## LAND CORNER RECORDATION CERTIFICATE Filing Requirement of Act 74, Mich. P.A. 1970

For corners in **COMMISSION**

MASON <small>(County)</small>	Located In:	Corner Code <b>#</b>
1. Public Land Survey	T <u>19N</u> R <u>17W</u>	E-13
	T _____ R _____	_____
	T _____ R _____	_____
	T _____ R _____	_____
2. Property Controlling in Section	S _____ T _____ R _____	<i>Seg. 1</i>
	S _____ T _____ R _____	
3. Miscellaneous Property in Sec.	S _____ T _____ R _____	_____

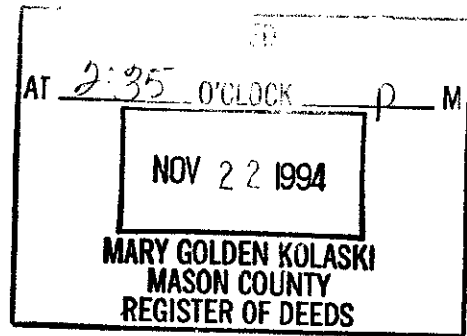

Register of Deeds Stamp & File Number

4. Lot No. \_\_\_\_\_, Recorded Plat \_\_\_\_\_  
5. Private Claims \_\_\_\_\_

I, Theodore H. Weinert, in a field survey on JULY, 1994, do hereby certify that under requirements of P.A. 74, Michigan P.A. of 1970, the corner points mentioned in lines 1 and 2 above were in conformance with regulations and rules therefore as required in the current manual of survey instructions of the United States Department of the Interior, Bureau of Land Management or by a decree of a Court of Law and/or that the corner points mentioned in lines 3, 4 and 5 above were in conformance with the rules of the Michigan Board of Land Surveyors or by a Decree of a Court of Law; established, re-established, monumented, re-monumented, recovered, found as expressed below:

	A	B	C	D	E	F	G	H	I	J	K	L	M
2	6	5	4	3	2	1							
3													
4	7	8	9	10	11	12							
5													
6	18	17	16	15	14	13							
7													
8	19	20	21	22	23	24							
9													
10	30	29	28	27	26	25							
11													
12	31	32	33	34	35	36							
13													

**NOTE: Not more than 4 corners, all in the same town and range, may be recorded on this certificate.**

**A. Description of original monument and accessories and/or subsequent restoration:**

E-13 Section Corner, Secs. 32 & 33

G.L.O. Notes Set Post  
1838 Sylvester Sibley  
15" Beech N 62 E 57 lks  
18" Beech N 52 W 50 lks  
May, 1899, R. O. Towns Rd stake and pieces of  
brick (Book 2, Page 45 & Book 4, Page 2)  
Stake for T18N, R17W, 46 lks East

Corner was reset by survey crew completing work  
for Consumer's Power Co. during the early 1960's

**B. Description of corner evidence found and/or method applied in restoring or reestablishing corner:**

E-13 Section Corner, Secs. 32 & 33

Found T iron and pieces of brick 30.36' west of  
corner common to sections 4 & 5, T18N, R17W, old  
witnesses were in place but no record was found.  
Fit distances within reason to North, South, and  
West as recorded by R. O. Towns.  
This corner location is accepted as a careful and  
faithful perpetuation of the original corner.

**C. Description of monument for corner and accessories established to perpetuate locating the position of the corner:**

E-13 Section Corner, Secs. 32 & 33

Replaced T iron with 5/8" X 36" rerod with  
standard 2 1/2" cap stamped "Mason County  
Remonumentation".  
10" W. Pine S 34 E 59.56'  
Stop Sign Post N 82 E 41.98'  
6" Maple N 40 E 70.70'  
12" Maple N 15 W 92.30'  
Tel Box N 80 W 28.60'  
Corner Common to Sections 4 & 5, T18N, R17W, East  
30.36'



Signed by *Theodore H. Weinert* Date 10/17/94  
Surveyor's Michigan License No. 19845

FORM APPROVED BY MICHIGAN STATE BOARD OF LAND SURVEYORS, JAN. 28, 1971  
REVISED MAY 14, 1975  
REVISED JAN., 1983

Peer Group Reviewed and Approved  
Date: 10-25-94  
*Kenneth L. Ross*  
Mason County Surveyor