

DEC 29 1998

LAND CORNER RECORDATION CERTIFICATE

Filing Requirement of Act 74, Mich. P.A.

1970 FILED
 AT 3:00 O'CLOCK P M
 NOV 21 1998
 MARY GOLDEN KOLASKI
 MASON COUNTY
 REGISTER OF DEEDS
 Register of Deeds Stamp & File Number

For corners in SECTION
 Mason (County) Located In: Corner Code #

1. Public Land Survey T 19N R 17W G-7
 T R
 T R
 T R

2. Property Controlling in Section S T R
 S T R

3. Miscellaneous S T R

Property in Sec. S T R

4. Lot No. , Recorded Plat
 5. Private Claims

1	A	B	C	D	E	F	G	H	I	J	K	L	M
2	6	5	4	3	2	1							
3													
4	7	8	9	10	11	12							
5													
6	18	17	16	15	14	13							
7													
8	19	20	21	22	23	24							
9													
10	30	29	28	27	26	25							
11													
12	31	32	33	34	35	36							
13													

I, Kenneth L. Ross, in a field survey on October 24, 1998, do hereby certify that under requirements of P.A. 74, Michigan P.A. of 1970, the corner points mentioned in lines 1 and 2 above were in conformance with regulations and rules therefore as required in the current manual of survey instructions of the United States Department of the Interior, Bureau of Land Management or by a decree of a Court of Law and/or that the corner points mentioned in lines 3, 4 and 5 above were in conformance with the rules of the Michigan Board of Land Surveyors or by a Decree of a Court of Law, established, re-established, monumented, re-monumented, recovered, found as expressed below:

NOTE: Not more than 4 corners, all in the same town and range, may be recorded on this certificate.

A. Description of original monument and accessories and/or subsequent restoration:
ORIGINAL GOVERNMENT SURVEY J.W. Griswold, 1892, Book 1, pg 262
 Section Survey by Sylvester Silbely Already established by (unreadable)
 1838 to 1839, Set Post Land Cleared Stumps all gone.
 (1) Beech, 16", N37°W, 5.28' Distance East to H-7, 2637.69'
 (2) Beech, 12" S72°E, 10.56' Distance South to G-8, 2600.07'

W.E. Metcalf, 1888, Book 1, pg. 209 Mason County Road Commission, undated
 States One Witness OK Found stone and horse shoes
 No New Witnesses Given. (3) P.P. N50°E, 41.8'
 Distance West to F-7, 2633.40 (4) Brace Pole, S41° 30" E, 50.2'
 Distance South to G-8, 2603.04' (5) P.P. S47°W, 52.00'
 1971, Found 1" Pipe, used old witnesses

Kenneth L. Ross, Survey, 1984
 Un Recorded, File No. H-341
 Tied this Corner.
 Distance South to G-8, 2612.38'

Theodore H. Weinert, LCRC, Liber 3,
 Page 65, Mason Co. Records,
 Found 5/8" iron Pin, Replaced with
 1 1/4" X24" Pipe and Monument Box
 (6) P.P. N30°E, 43.88'
 (7) P.P. S45°W, 53.85'
 (8) Light Pole, N50°W, 89.85'

B. Description of corner evidence found and/or method applied in restoring or reestablishing corner:

Found 1 1/4" pipe as described above in monument box in the center-line of Stiles Road.


Condition of record witnesses as follows: (1) gone, (2) gone, (3) gone, (4) gone, (5) gone, (6) in good condition, (7) in good condition, (8) in good condition.

C. Description of monument for corner and accessories established to perpetuate locating the position of the corner:

Placed a 5/8" X 24" re-rod inside the 1 1/4" pipe inside the monument box with a 3 1/2" aluminum cap stamped "Mason County Monument". This corner is accepted as a careful and faithful re-establishment of the location of the original corner.

- Ex "BP" (6) P.P. N 30°E, 43.88 feet, (60d spike SE side)
- Ex "BP" (7) P.P. S45°W, 53.85 feet, (60d spike SE side)
- Ex "BP" (8) Light Pole, N 50°W, 89.85 feet, (60d spike NE side) ↗
- (9) Guy Pole, S 38°E, 50.85 feet. (60d spike NE side)

Signed by Kenneth L. Ross Date 11-19-98
 Surveyor's Michigan License No. 17634

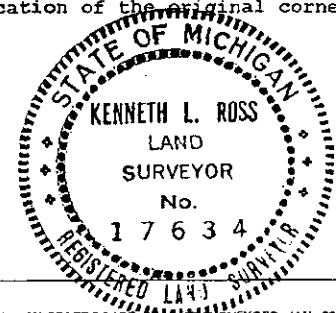

Approved by Peer Review Group On 11-19-98
 Kenneth L. Ross, County Representative