


**SURVEY &
REMONUMENTATION**

OCT 28 1996

COMMISSION

LAND CORNER RECORDATION CERTIFICATE

Filing Requirement of Act 74, Mich. P.A. 1970

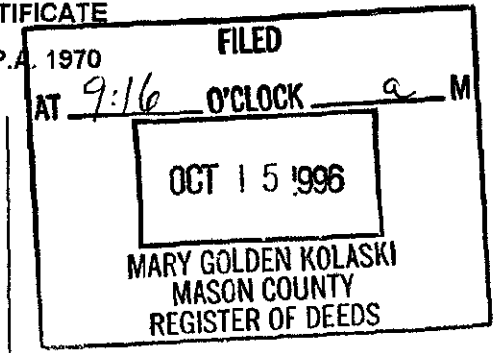

Register of Deeds Stamp & File Number

For corners in
Mason County
(County)

Located In: _____ Corner Code # _____

1. Public Land Survey T 19N R 17W G-11
 T _____ R _____
 T _____ R _____
 T _____ R _____

2. Property Controlling S _____ T _____ R _____
 in Section S _____ T _____ R _____

3. Miscellaneous S _____ T _____ R _____
 Property in Sec. S _____ T _____ R _____

4. Lot No. _____ Recorded Plat _____

5. Private Claims _____

	A	B	C	D	E	F	G	H	I	J	K	L	M
2	6	5	4	3	2	1							
3													
4	7	8	9	10	11	12							
5													
6	18	17	16	15	14	13							
7													
8	19	20	21	22	23	24							
9													
10	30	29	28	27	26	25							
11													
12	31	32	33	34	35	36							
13													

I, Theodore H. Weinert, in a field survey on September 12, 1996, do hereby certify that under requirements of P.A. 74, Michigan P.A. of 1970, the corner points mentioned in lines 1 and 2 above were in conformance with regulations and rules therefore as required in the current manual of survey instructions of the United States Department of the Interior, Bureau of Land Management or by a decree of a Court of Law and/or that the corner points mentioned in lines 3, 4 and 5 above were in conformance with the rules of the Michigan Board of Land Surveyors or by a Decree of a Court of Law; established, re-established, monumented, re-monumented, recovered, found as expressed below:

NOTE: Not more than 4 corners, all in the same town and range, may be recorded on this certificate.

A. Description of original monument and accessories and/or subsequent restoration:
 Sylvester Sibley, subdivided the Township in 1838 and 1839. Stated "set post common to sections 27, 28, 33 and 34". Witnesses given: (1) Beech, 8", S33°E, 10 links, (2) do, 6", N9°W, 12 links. In 1888, W.E. Metcalf surveyed Section 28 and tied this corner. Stated "Found Stone by Eastman". No Witnesses given. In 1905, R.O. Towns completed a survey in Section 27 and tied this corner. Stated Located Stone, No witnesses given. In the 1960s Consumers Power Co. completed a survey of Section 28, No witnesses given. Sam Barnett, RLS has record of this corner on an older survey undated. 1 1/4" pipe and stone. Witnesses given: (3) 15" Maple, S76°W, 31.5', (4) 12" Elm, S67°E, 62.5'. Sam Barnett also has record of this corner (undated) 1/2" iron, witnesses given: (5) 24" Maple, S50°W, 38.56', (6) P.P. N55°W, 59.21', (7) P.P. N35°E, 57.09', (8) Rd Name sign, S35°E, 51.32'. On 12/30/74, Herbert L. Fluharty, RLS, filed an LCRC on this corner, Liber 1, page 267, Stated "found 5/8" rod in Mon. Box. Witnesses given: (9) P.P. S43°E, 57.09', (10) P.P. S33°W, 58.42', (11) P.P. N66°W, 72.83'. On 1/10/92 Theodore H. Weinert filed an LCRC, Liber 3, page 64, Stated "Replaced 3/8" rod with 1 1/4" X 2' pipe and cap. Witnesses given: (12) P.P. S25°E, 57.14', (13) P.P. N45°W, 77.38', (14) Guy Pole, S22°W, 58.38'. On November 18, 1993, Kenneth L. Ross, Completed a survey of Section 34, tying into this corner, No Witnesses Given.

B. Description of corner evidence found and/or method applied in restoring or reestablishing corner:
 On September 12, 1996, I found the 1 1/4" X 2' pipe and cap # 19846 as described in A. above and set by myself in 1992. Witnesses (1) through (8) have been destroyed or relocated. Witnesses (9) (12) (13) and (14) are in and in good condition. Witness (10) and (11) have been destroyed. I cross pinned the existing pipe and tried to pull but, could not remove.

C. Description of monument for corner and accessories established to perpetuate locating the position of the corner:
 I removed the plastic cap #19846 and placed a Standard Mason County Monument the pipe, inside a monument box as a careful and faithful reestablishment of the position of the original corner.
 Witnesses checked or taken:
 (9) Spike in P.P. S43°E, 57.09'
 (12) Spike in P.P. S25°E, 57.13'
 (13) Spike in P.P. S45°W, 77.38'
 (14) Spike in Guy Pole, S22°W, 58.38'

Signed by *Theodore H. Weinert* Date 9/30/96
 Surveyor's Michigan License No. 19846
 Peer Group Reviewed and Approved
 Date: 9-30-96
Kenneth L. Ross
 Mason County Surveyor
 FORM APPROVED BY MICHIGAN STATE BOARD OF LAND SURVEYORS, JAN. 28, 1971
 REVISED MAY 14, 1975
 REVISED JAN., 1983
 ADAPTED FOR WORD PROCESSING MARCH, 1993
 110ED A PAGE 86