

DEC 29 1998

LAND CORNER RECORDATION CERTIFICATE

Filing Requirement of Act 74, Mich. P.A. 1970

SECTION

For corners in Mason (County)

Located In:

Corner Code #

Register of Deeds Stamp & File Number. Filed at 3:01 O'CLOCK P.M. NOV 21 1998 MARY GOLDEN KOLASKI MASON COUNTY REGISTER OF DEEDS

- 1. Public Land Survey T 19N R 17W H-9
2. Property Controlling in Section S T R
3. Miscellaneous S T R
Property in Sec. S T R

- 4. Lot No. Recorded Plat
5. Private Claims

I, Kenneth L. Ross, in a field survey on October 17, 1998, do hereby certify that under requirements of P.A. 74, Michigan P.A. of 1970, the corner points mentioned in lines 1 and 2 above were in conformance with regulations and rules therefore as required in the current manual of survey instructions of the United States Department of the Interior, Bureau of Land Management or by a decree of a Court of Law and/or that the corner points mentioned in lines 3, 4 and 5 above were in conformance with the rules of the Michigan Board of Land Surveyors or by a Decree of a Court of Law; established, re-established, monumented, re-monumented, recovered, found as expressed below:

NOTE: Not more than 4 corners, all in the same town and range, may be recorded on this certificate.

A. Description of original monument and accessories and/or subsequent restoration: H-9 Quarter Corner Common to Section 22 and 27, T.19N., R.17W.,

ORIGINAL GOVERNMENT SURVEY Sylvester Sibley, 1838 to 1839 Set Post, (1) Beech, 14", N2°W, 14.54' (2) Beech, 8", S42°E, 7.26'

CLINTON E. COLE, RLS, Act 132 Liber 1, page 410, 1976 (4) 20" Cherry, South 27.00' (5) 12" Maple, S5°E, 50.89' (30.89') (6) 22" Maple, S45°E, 51.14'

Several unrecorded surveys at Mason County Surveyor's Office tied this corner. No Witnesses Given. From 1976 thru 1997

J.W. GRISWOLD, 1892, Book 1, pg. 262 Set Corner by Measurement, No Witnesses Distance East to I-9, 2625.81' Distance West to G-9, 2625.81'

KENNETH L. ROSS, RLS, Survey Unrecorded, 1976, existing iron (4) 16" Cherry, South 27.29', (4) (7) 16" Maple, S20°E, 41.39', (8) P.P. N70°E, 88.09'

MASON COUNTY ROAD COMMISSION, No date Fd. 1 1/2" Pipe (3) Fence Corner, South, 31.4'

B. Description of corner evidence found and/or method applied in restoring or reestablishing corner: H-9 Quarter Corner Common to Section 22 and 27, T.19N., R.17W.,

On October 17, 1998, I found pipe as described above 8" below the surface of the road, it was 1 1/2" diameter with a T iron inside and measured 3 foot long with a horse shoe lying on the north side. I found no other evidence to dispute this location for the corner.

Condition of recorded witnesses are as follows: (1) Gone, (2) Gone, (3) Gone, (4) Found in good condition, (5) found in fair condition, (6) Found in fair condition, (7) Gone, (8) Gone.


C. Description of monument for corner and accessories established to perpetuate locating the position of the corner: H-9 Quarter Corner Common to Sections 22 and 27, T.19N., R.17W.,

I replaced the 1 1/2" pipe as described above in the exact location, with a Harrison cast iron monument stamped MASON COUNTY MONUMENT, placed 1.0 feet below the road surface. This corner is accepted as a careful and faithful re-establishment of the position of the original corner.

- Ext. "BT" (4) Cherry, 20", South, 27.29', (60d spike in East Side) (9) RLS, 17634 iron and cap, North, 33.05' (10) 6" X 6" treated Gate Post, N 49° W, 53.12', (60d spike in NE side) (11) P.P. N 80° E, 97.00', (60d spike in North side) (12) 30" Maple, S40°E, 41.44', (60d spike in SW side) (13) Center of Fiber Optic Guard Post, S63°W, 75.61 feet

Signed by [Signature] Date 11-19-98

Surveyor's Michigan License No. 17634

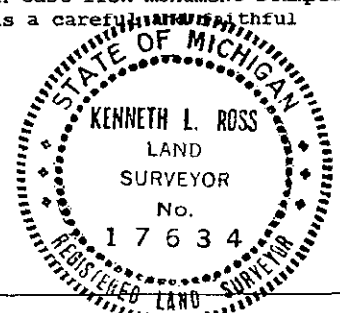

Approved by Peer Review Group On 11-19-98 Kenneth L. Ross, County Representative [Signature]

FORM APPROVED BY MICHIGAN STATE BOARD OF LAND SURVEYORS, JAN. 28, 1971 REVISED MAY 14, 1975 REVISED JAN. 1983 ADAPTED FOR WORD PROCESSING MARCH, 1993