


DEC 18 1995

COMMISSION

LAND CORNER RECORDATION CERTIFICATE
Filing Requirement of Act 74, Mich. P.A. 1970

For corners in

MASON (County)	Located In:	Corner Code -#
1. Public Land Survey	T 19N R 17W	H-13
	T _____ R _____	_____
	T _____ R _____	_____
	T _____ R _____	_____
2. Property Controlling in Section	S _____ T _____ R _____	_____
	S _____ T _____ R _____	_____
3. Miscellaneous Property in Sec.	S _____ T _____ R _____	_____
	S _____ T _____ R _____	_____

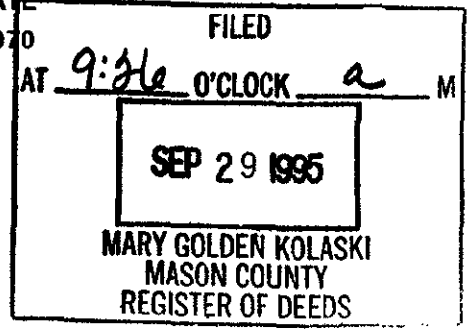

Register of Deeds Stamp & File Number

4. Lot No. _____, Recorded Plat _____
5. Private Claims _____

	A	B	C	D	E	F	G	H	I	J	K	L	M
2	6	5	4	3	2	1							
3													
4	7	8	9	10	11	12							
5													
6	18	17	16	15	14	13							
7													
8	19	20	21	22	23	24							
9													
10	30	29	28	27	26	25							
11													
12	31	32	33	34	35	36							
13													

I, Sammy S. Barnett, in a field survey on SEPTEMBER, 1995, do hereby certify that under requirements of P.A. 74, Michigan P.A. of 1970, the corner points mentioned in lines 1 and 2 above were in conformance with regulations and rules therefore as required in the current manual of survey instructions of the United States Department of the Interior, Bureau of Land Management or by a decree of a Court of Law and/or that the corner points mentioned in lines 3, 4 and 5 above were in conformance with the rules of the Michigan Board of Land Surveyors or by a Decree of a Court of Law; established, re-established, monumented, re-monumented, recovered, found as expressed below:

NOTE: Not more than 4 corners, all in the same town and range, may be recorded on this certificate.

A. Description of original monument and accessories and/or subsequent restoration:

H-13 South 1/4 Corner for Section 34, T19N, R17W, on the township line

<u>1838, Mullett & Brookfield, Boundary</u>	<u>1989, Ken Ross, M.C.S.</u>
Set Wood Post @ 40 Chains	Found 1/2" Re-rod
#1 Beech 7" N67°E 401k.(26.40')	No new witnesses
#2 Beech 9" N46°W 271k.(17.82')	Measured 2640.99' to SE Cor. Sec. 34

1910, H.F. Johnson, Dep. C. S.
Set Stake @ double proportionate measurement
2642.64' East & West

B. Description of corner evidence found and/or method applied in restoring or reestablishing corner:

H-13 South 1/4 Corner for Section 34, T19N, R17W, on the township line

On September 14, 1995, I found a 1/2" Re-rod, 1.0 foot long, placed 5 feet North of the center-line of Decker Road (gravel), I also found a very old fence line, lying down to the North and a fence corner post 38 feet South. I also located the North 1/4 Corner, for Section 1, T18N, R17W, a distance of 20.95 feet, East. I found no other evidence to dispute this location for the Corner. Condition of recorded witnesses is; #1 Gone #2 Gone

C. Description of monument for corner and accessories established to perpetuate locating the position of the corner:

H-13 South 1/4 Corner for Section 34, T19N, R17W, on the township line

I replaced 1/2" Re-rod with a 5/8" Re-rod, 24" long, with an aluminum cap, stamped MASON COUNTY MONUMENT, I placed the monument 0.5 feet below gravel road 5 feet North of center-line, and is accepted as a careful and faithful reestablishment of the position of the original corner.

- Maple 8" S 17° W 45.52'(60d spike in NW side of tree)
- Twin Maple 5" N 38° W 38.27'(60d spike in NE side of tree)
- Concrete Monument (Ross RLS Cap) S 28° E 40.37'
- MASON COUNTY MONUMENT (2 1/2" aluminum capped re-rod) East 20.95'



Signed by Sammy S. Barnett Date 9-28-95

Surveyor's Michigan License No. 16923
Peer Group Reviewed and Approved
Date: 9-28-95
Kenneth L. Ross
Mason County Surveyor