

SECTION

LAND CORNER RECORDATION CERTIFICATE

Filing Requirement of Act 74, Mich. P.A. 1970

For corners in
Mason
 (County)

Located In: _____ Corner Code # _____

1. Public Land Survey T 19N R 17W I-8
 T _____ R _____
 T _____ R _____
 T _____ R _____

2. Property Controlling S _____ T _____ R _____
 in Section S _____ T _____ R _____

3. Miscellaneous S _____ T _____ R _____

Property in Sec. S _____ T _____ R _____

4. Lot No. _____, Recorded Plat _____

5. Private Claims _____

FILED

AT 3:07 O'CLOCK P M

NOV 21 1998

MARY GOLDEN KOLASKI
 MASON COUNTY
 REGISTER OF DEEDS

Register of Deeds Stamp & File Number

1	A	B	C	D	E	F	G	H	I	J	K	L	M
2	6	5	4	3	2	1							
3													
4	7	8	9	10	11	12							
5													
6	18	17	16	15	14	13							
7													
8	19	20	21	22	23	24							
9													
10	30	29	28	27	26	25							
11													
12	31	32	33	34	35	36							
13													

I, Kenneth L. Ross, in a field survey on October 17, 1998, do hereby certify that under requirements of P.A. 74, Michigan P.A. of 1970, the corner points mentioned in lines 1 and 2 above were in conformance with regulations and rules therefore as required in the current manual of survey instructions of the United States Department of the Interior, Bureau of Land Management or by a decree of a Court of Law and/or that the corner points mentioned in lines 3, 4 and 5 above were in conformance with the rules of the Michigan Board of Land Surveyors or by a Decree of a Court of Law, established, re-established, monumented, re-monumented, recovered, found as expressed below:

NOTE: Not more than 4 corners, all in the same town and range, may be recorded on this certificate.

A. Description of original monument and accessories and/or subsequent restoration:
ORIGINAL GOVERNMENT SURVEY Section Survey by Sylvester Silbely 1838 to 1839, Set Post
 (1) Beech, 10", N38°W, 15.18'
 (2) Beech, 10" S58°E, 6.6'

Kenneth L. Ross, Survey, 1993, Unrecorded Ex. Conc. Monument
 (3) P.P. N10°E, 15.36'
 (4) P.P. S06°E, 147.25'
 (5) Fence Post, N82°W, 25.61'
 (6) 12" Red Pine, N56°W, 42.05'

J. W. Griswold, 1892, Book 1, Pg. 262
 Set By Measurement
 No Witnesses Given.
 Distance North to I-7, 2628.78'
 Distance South to I-9 2628.78'

Plat of "Timber Haven, Liber 3 of Plats, Page 27,
 Tied this corner and set Concrete Monument, East, 33.00 feet


B. Description of corner evidence found and/or method applied in restoring or reestablishing corner:

Found a 1/2" X 18" re-rod in a broken concrete monument in the center-line of Amber Road. Existing Fence line to the West.

Condition of record witnesses as follows: (1) gone, (2) gone, (3) removed, (4) in good condition, (5) in good condition, (6) in good condition.

C. Description of monument for corner and accessories established to perpetuate locating the position of the corner:

I replaced the 1/2" X 18" Re-rod in the exact location, with a 5/8" X 24 " re-rod with a 3 1/2" aluminum cap stamped "Mason County Monument" Leaving the broken pieces of concrete in place. This corner is accepted as careful and faithful re-establishment of the location of the original corner.
 Ex "B.T." (4) P.P. S06°E, 147.25 feet, (60d spike SW side)
 Ex "B.T." (5) Fence Post N 82° W, 25.61 feet, (6d nail with washer North side)
 Ex "B.T." (6) 12" Red Pine N56°W, 42.05 feet, (60d spike SW side)
 (7) Clump Maple, S 58° W, 33.57 feet, (60d spike NW side)
 (8) Concrete Monument, East, 33.02 feet

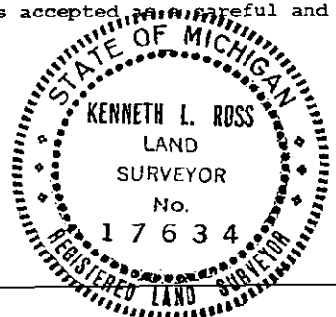

Signed by [Signature] Date 11-19-98
 Surveyor's Michigan License No. 17634

Approved by Peer Review Group On 11-19-98
 Kenneth L. Ross, County Representative [Signature]