

**SURVEY &
REMONUMENTATION**


DEC 18 1995

COMMISSION

**LAND CORNER RECORDATION CERTIFICATE
Filing Requirement of Act 74, Mich. P.A. 1970**

For corners in

MASON	Located In:	Corner Code #
(County)		
1. Public Land Survey	T 19 N R 17 W	I 13
	T _____ R _____	_____
	T _____ R _____	_____
	T _____ R _____	_____
2. Property Controlling in Section	S _____ T _____ R _____	_____
	S _____ T _____ R _____	_____
3. Miscellaneous Property in Sec.	S _____ T _____ R _____	_____
	S _____ T _____ R _____	_____

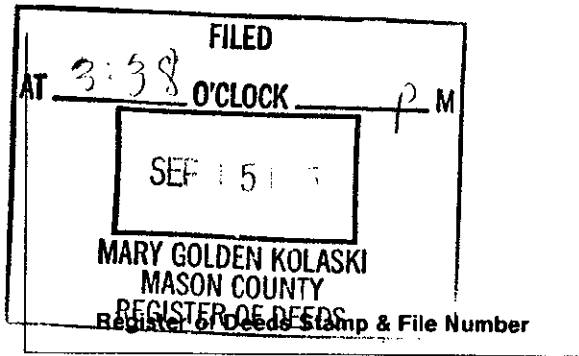

4. Lot No. _____, Recorded Plat _____
5. Private Claims _____

	A	B	C	D	E	F	G	H	I	J	K	L	M
2	6		5		4		3		2		1		
3													
4	7		8		9		10		11		12		
5													
6	18		17		16		15		14		13		
7													
8	19		20		21		22		23		24		
9													
10	30		29		28		27		26		25		
11													
12	31		32		33		34		35		36		
13													

I, Sammy S. Barnett, in a field survey on 8-31, 1995, do hereby certify that under requirements of P.A. 74, Michigan P.A. of 1970, the corner points mentioned in lines 1 and 2 above were in conformance with regulations and rules therefore as required in the current manual of survey instructions of the United States Department of the Interior, Bureau of Land Management or by a decree of a Court of Law and/or that the corner points mentioned in lines 3, 4 and 5 above were in conformance with the rules of the Michigan Board of Land Surveyors or by a Decree of a Court of Law; established, re-established, monumented, re-monumented, recovered, found as expressed below:

NOTE: Not more than 4 corners, all in the same town and range, may be recorded on this certificate.

A. Description of original monument and accessories and/or subsequent restoration:

I-13 Section Corner for Sections 34 and 35, on the township line, T19N, R17W
1837, Mullett & Brookfield, boundary
Set Wood Post
#1 Hemlock 12" N44°E 25 lk.(15.84')
#2 Hemlock 18" N33°W 18 lk(11.88')
1910, H.F. Johnson, MCS
Set Stake from G.L.O. witness
no witnesses taken

B. Description of corner evidence found and/or method applied in restoring or reestablishing corner:

I-13 Section Corner for Sections 34 and 35, on the township line, T19N, R17W
On September 5, 1995, I found a 1" Iron Pipe placed at the West bank of Amber Road, I measured East a distance of 15.81 feet as Recorded in several Surveys to the Section Corner for 2 and 3, T18N, R17W. Ref; Surveys Ken Ross, file No. Q-140, 35189s and 01190s, and found a 1/2" Re-rod with RLS cap #21756(Dunlap) I search for other Irons or markers or any other evidence, but found nothing to dispute this location. Condition of Recorded Witnesses is; #1 Gone #2 Gone

C. Description of monument for corner and accessories established to perpetuate locating the position of the corner:


I-13 Section Corner for Sections 34 and 35, on the township line, T19N, R17W.
I left the 1" Iron Pipe were found and placed a 5/8" Re-rod, 24" long, with an aluminum cap, stamped MASON COUNTY MONUMENT inside Iron Pipe, Monument is 0'3 foot above the ground, and is accepted as a careful and faithful reestablishment of the location of the original corner.

- Red Oak 36" N 27° W 22.60'(60d spike in SW side of tree)
- S. Maple 17" N 50° E 40.55'(60d spike in NW side of tree)
- Cherry 20" S 77° E 33.65'(60d spike in NW side of tree)
- Red Oak 10" N 88° E 30.00'(60d spike in SW side of tree)

Signed by Sammy S. Barnett Date 9-8-95

Surveyor's Michigan License No. 16973

Peer Group Reviewed and Approved
Date: 7-26-95
Kenneth L. Ross
Mason County Surveyor

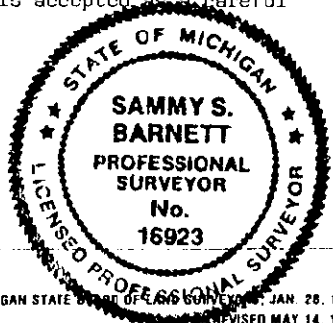

LIBER 3 PAGE 295